




NOTE:  
 1) 8" BREECHING PIPES FURNISHED WITH  
 BAROMETRIC DAMPERS

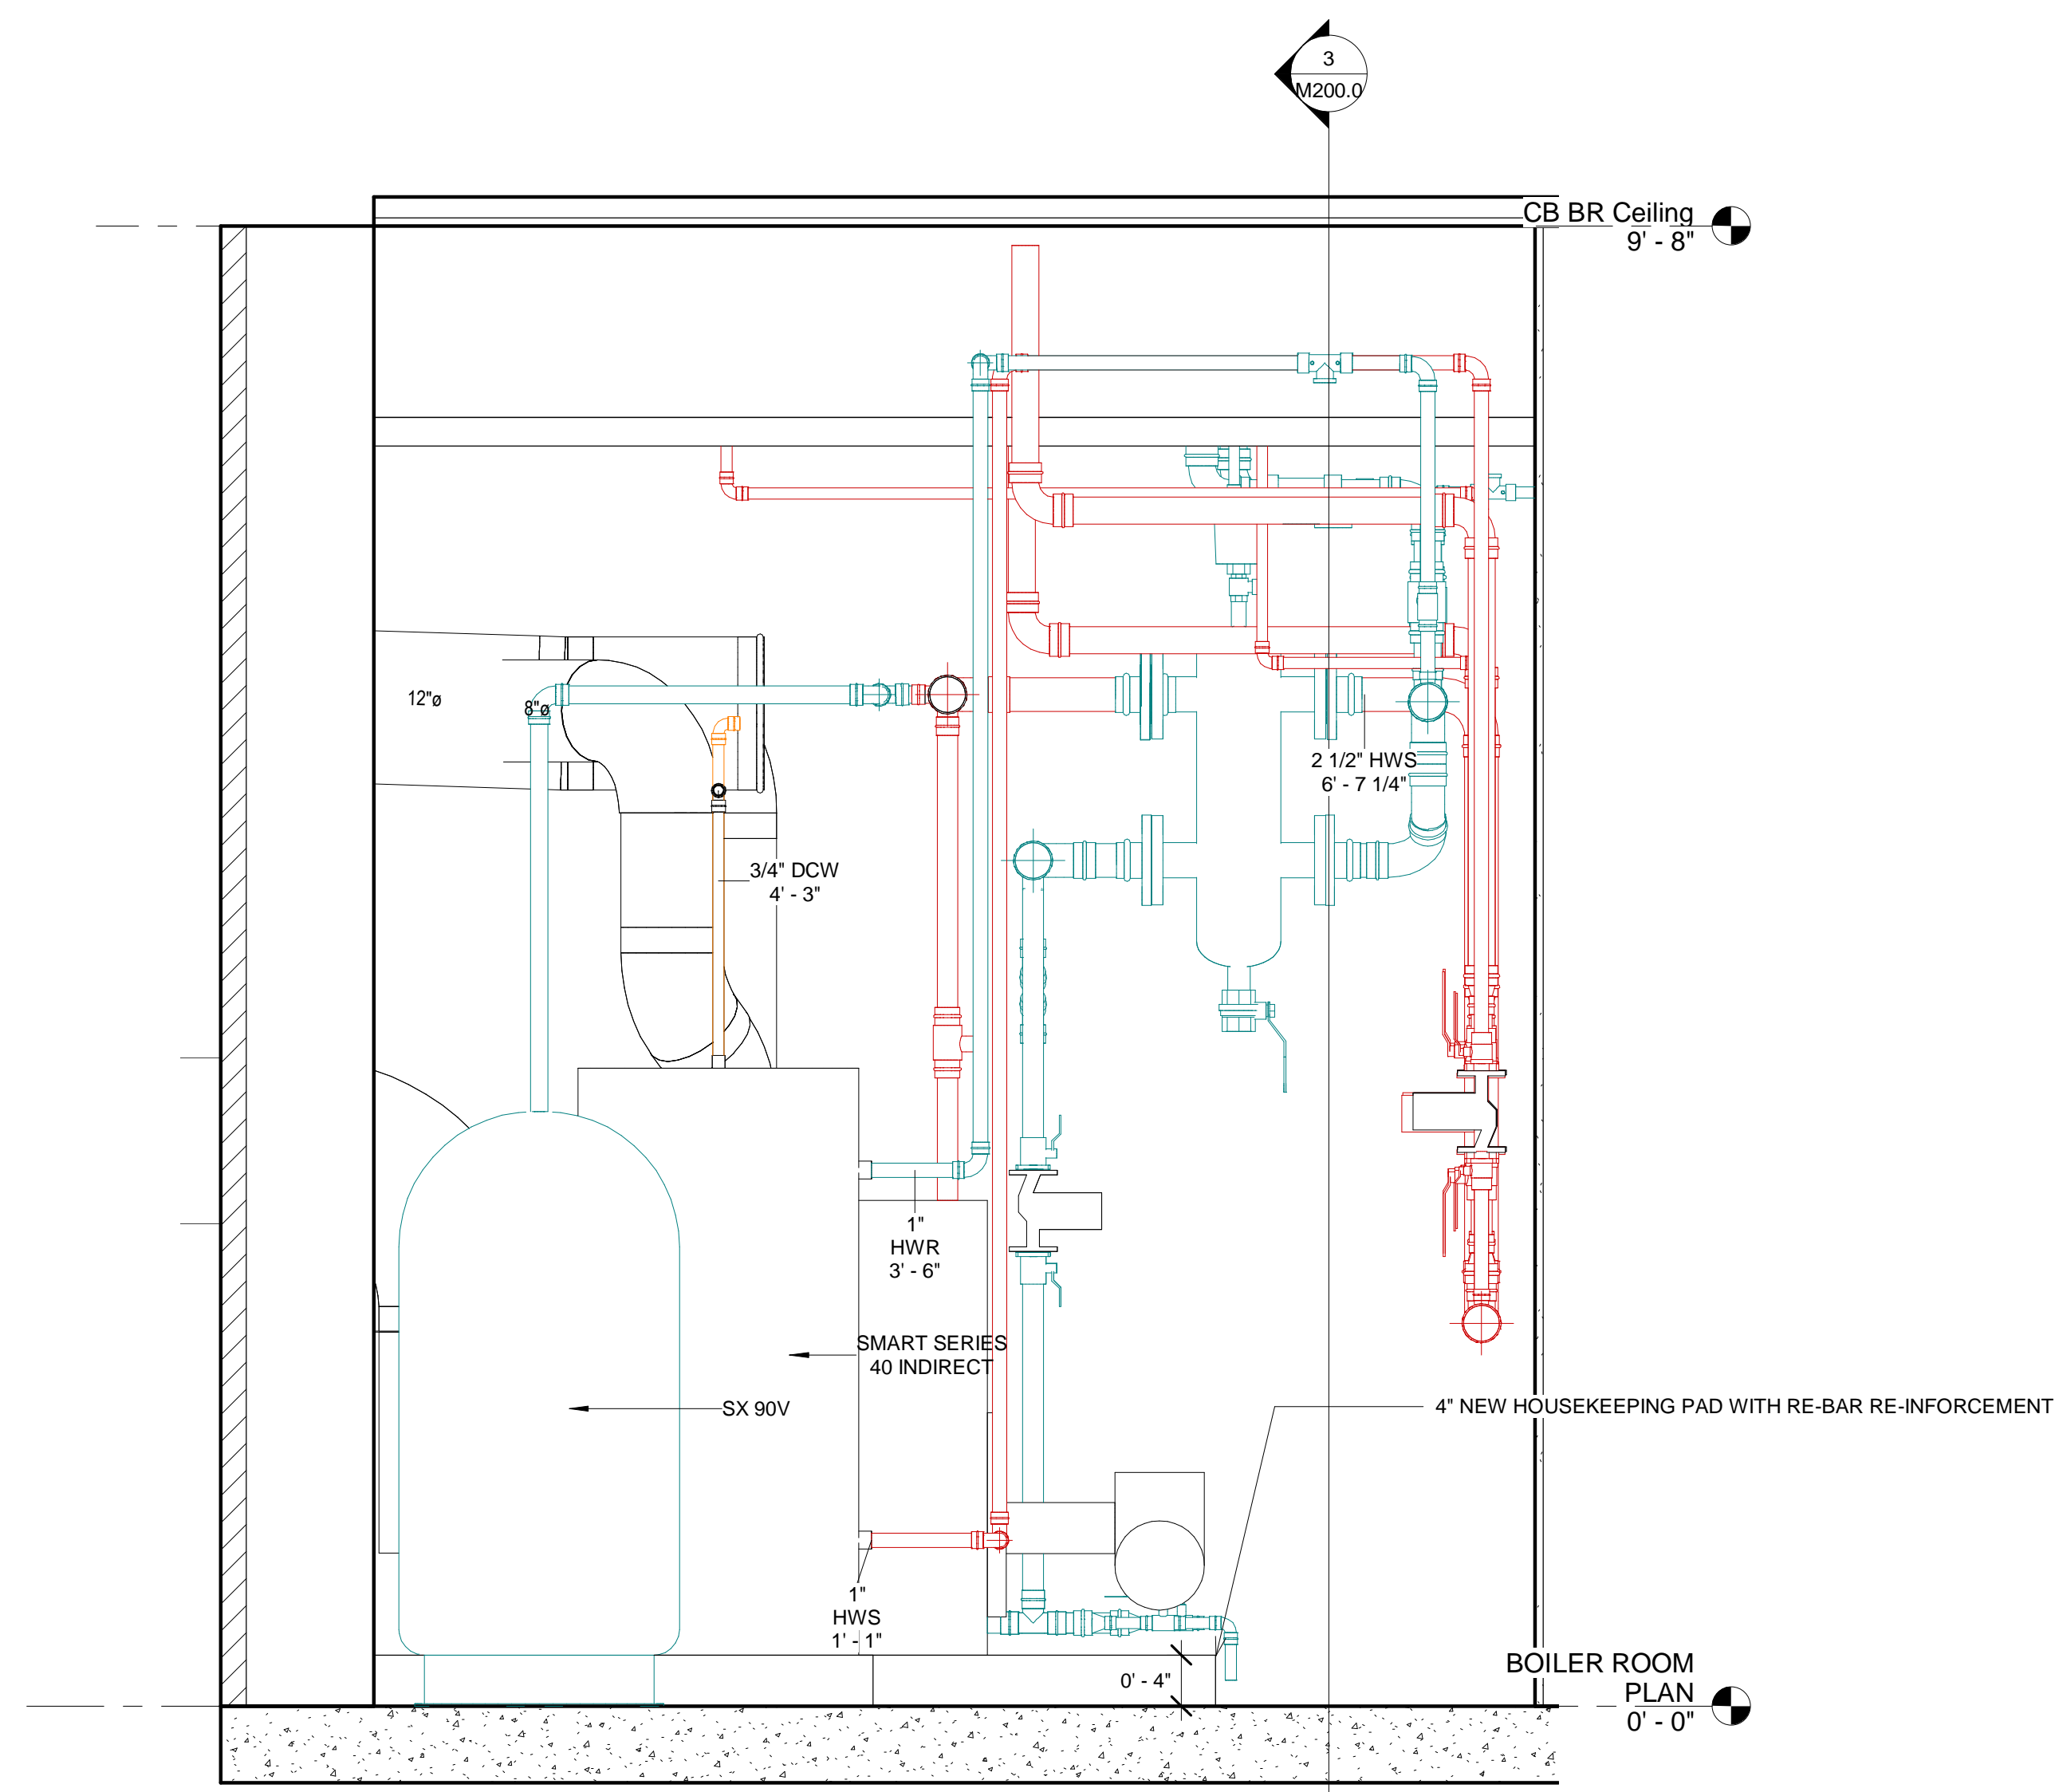


2 Section 3  
1" = 1'-0"

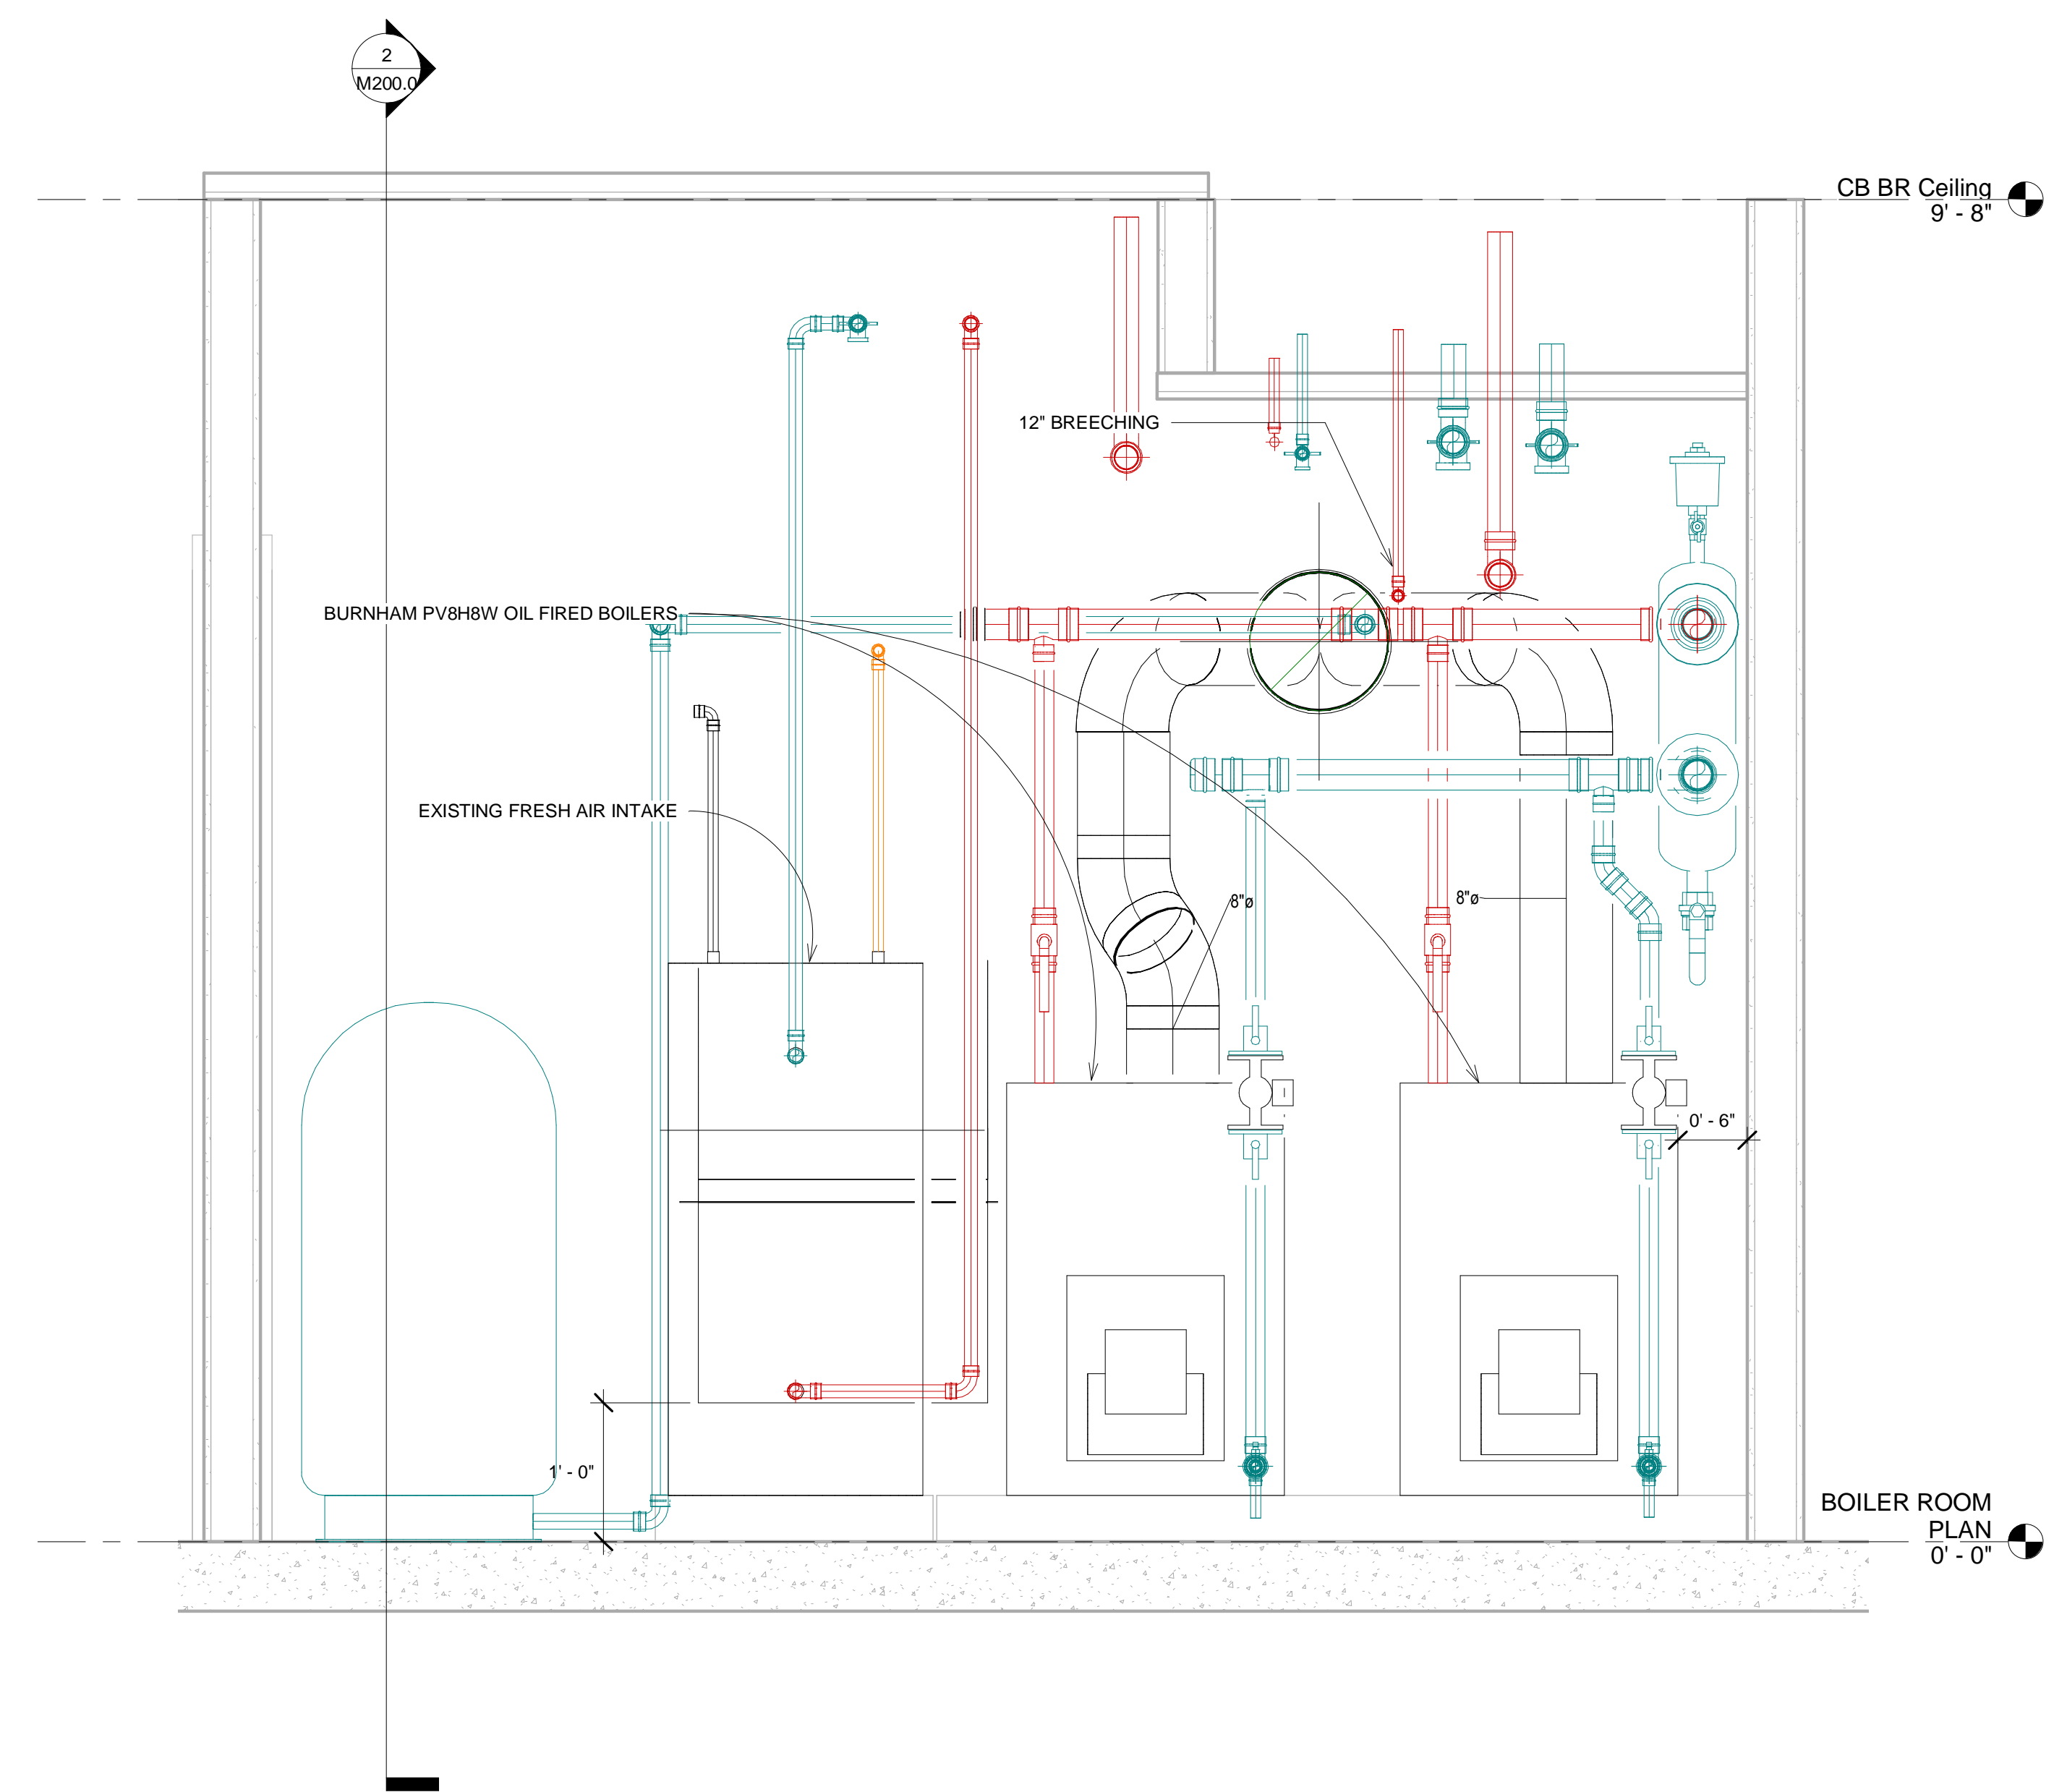

3 Section 4  
1" = 1'-0"

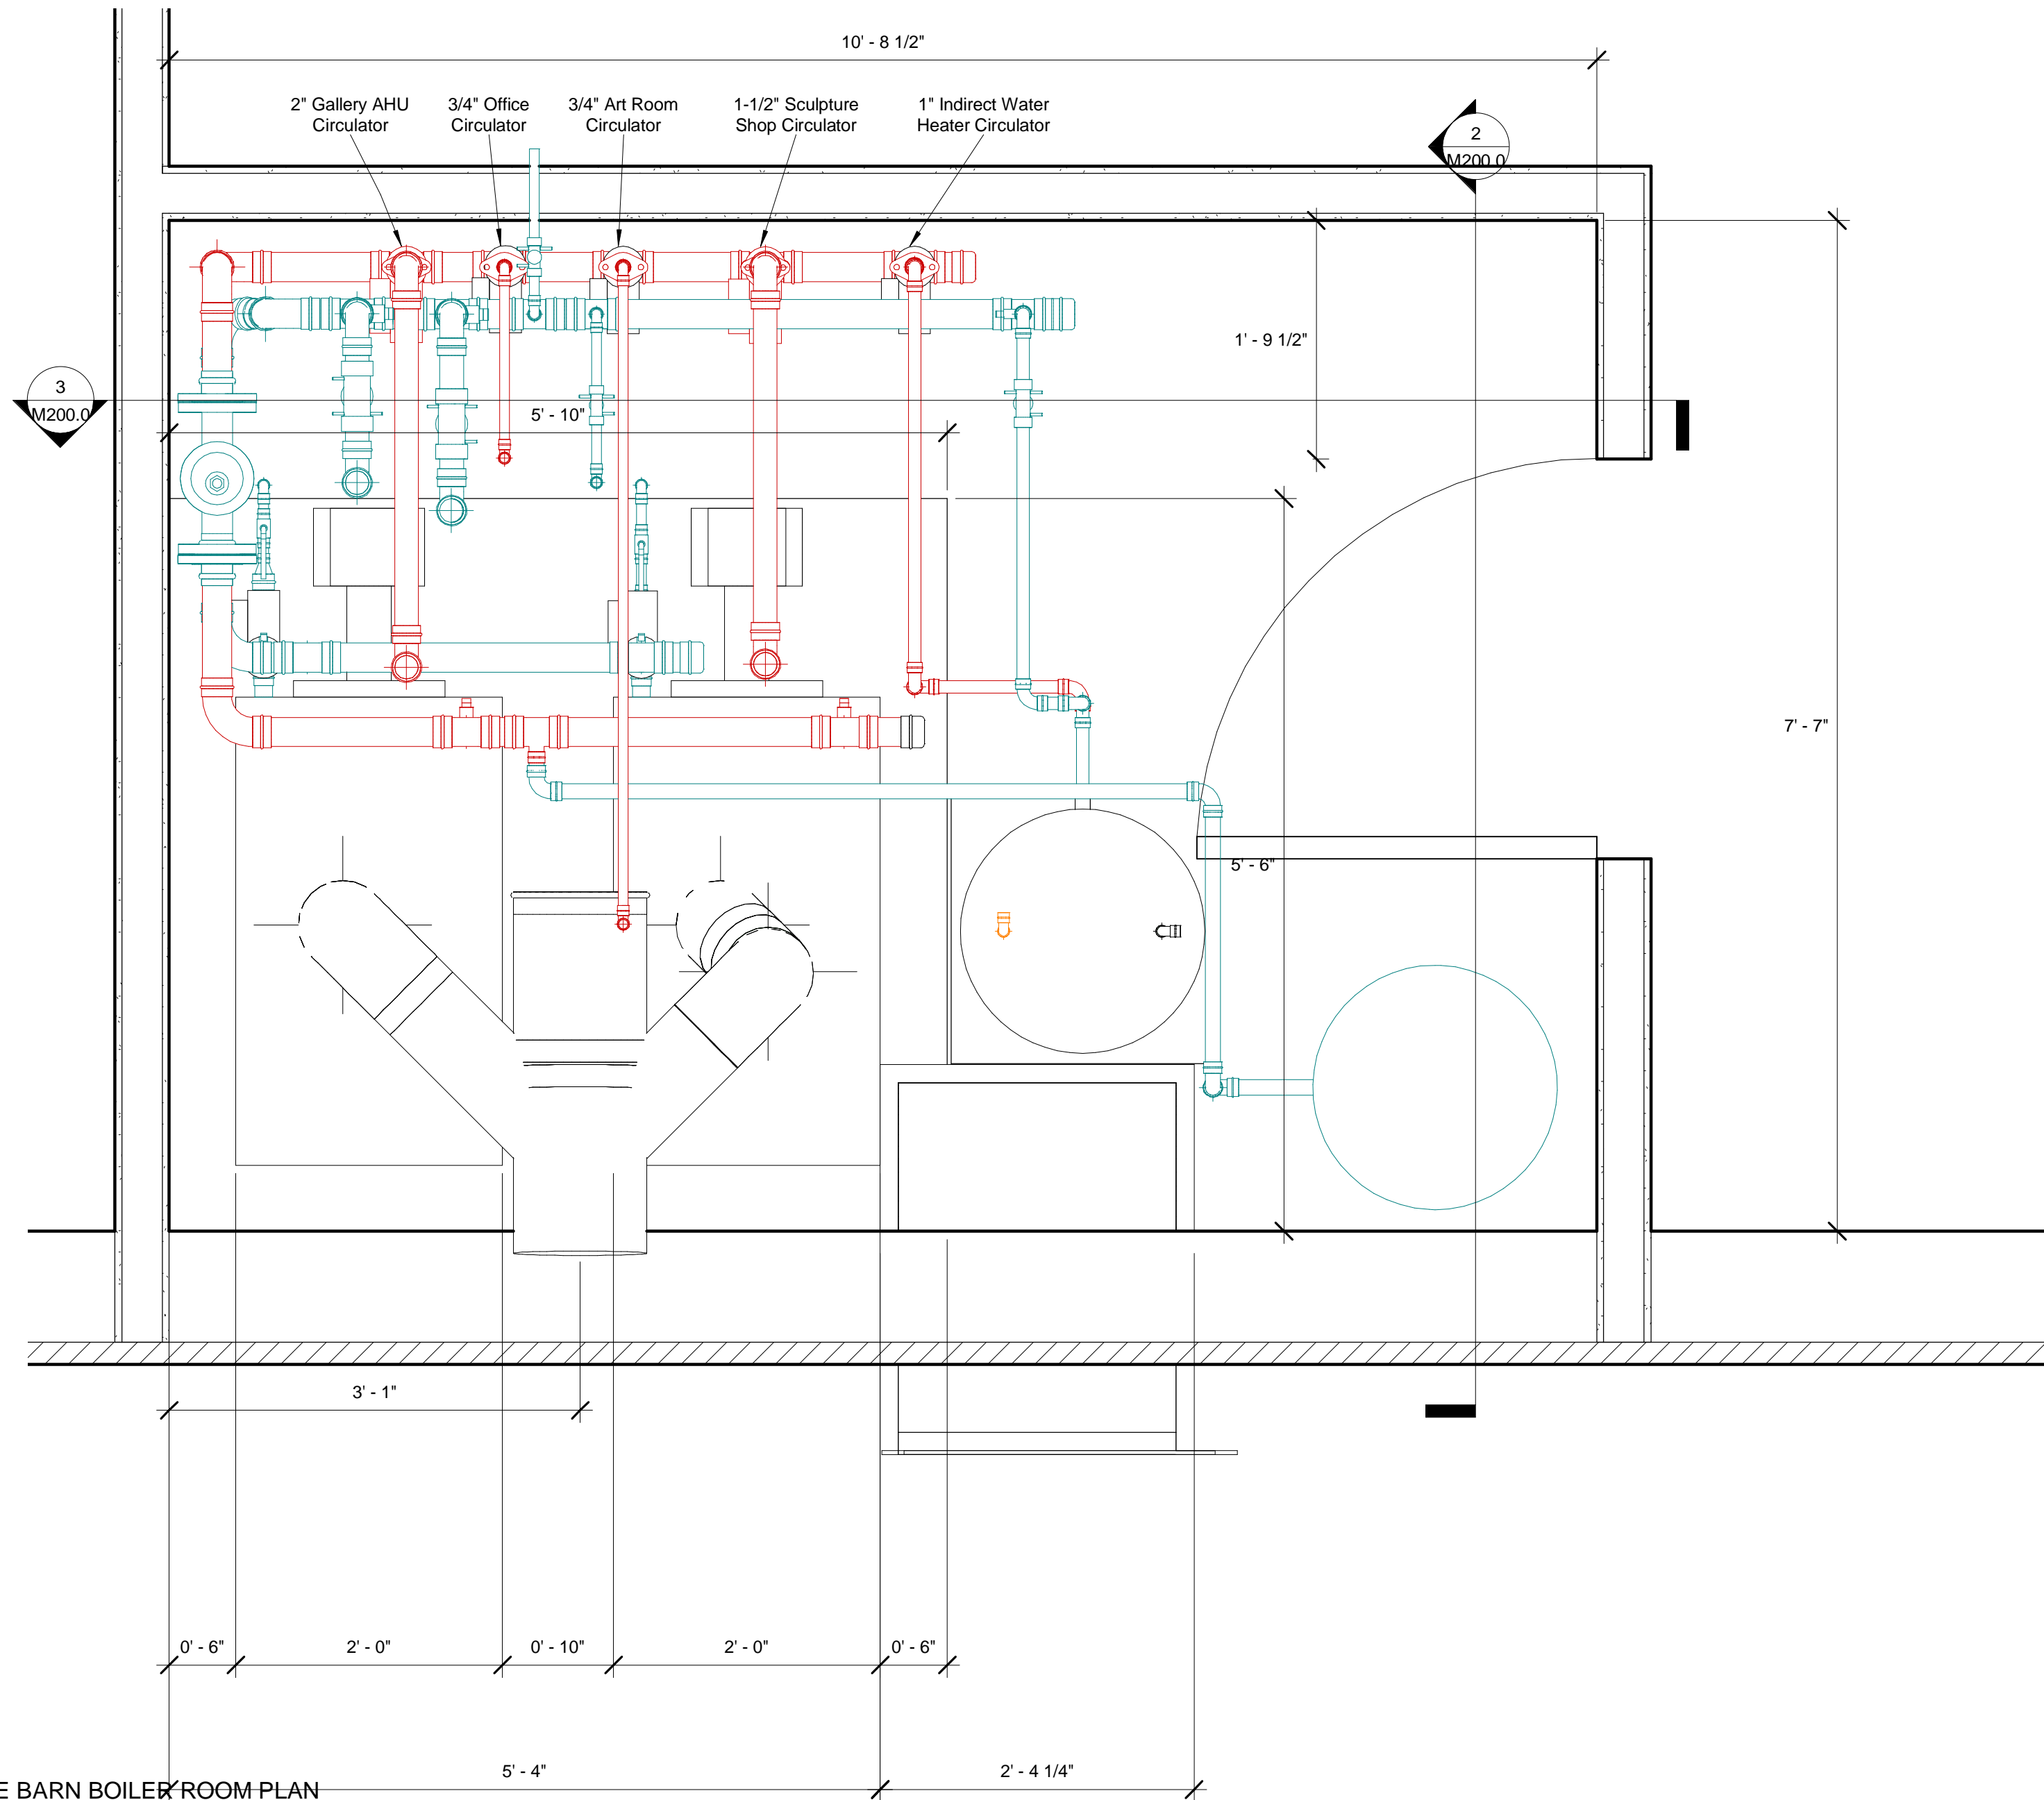

1 CARRIAGE BARN BOILER ROOM PLAN  
HDDLN  
1" = 1'-0"

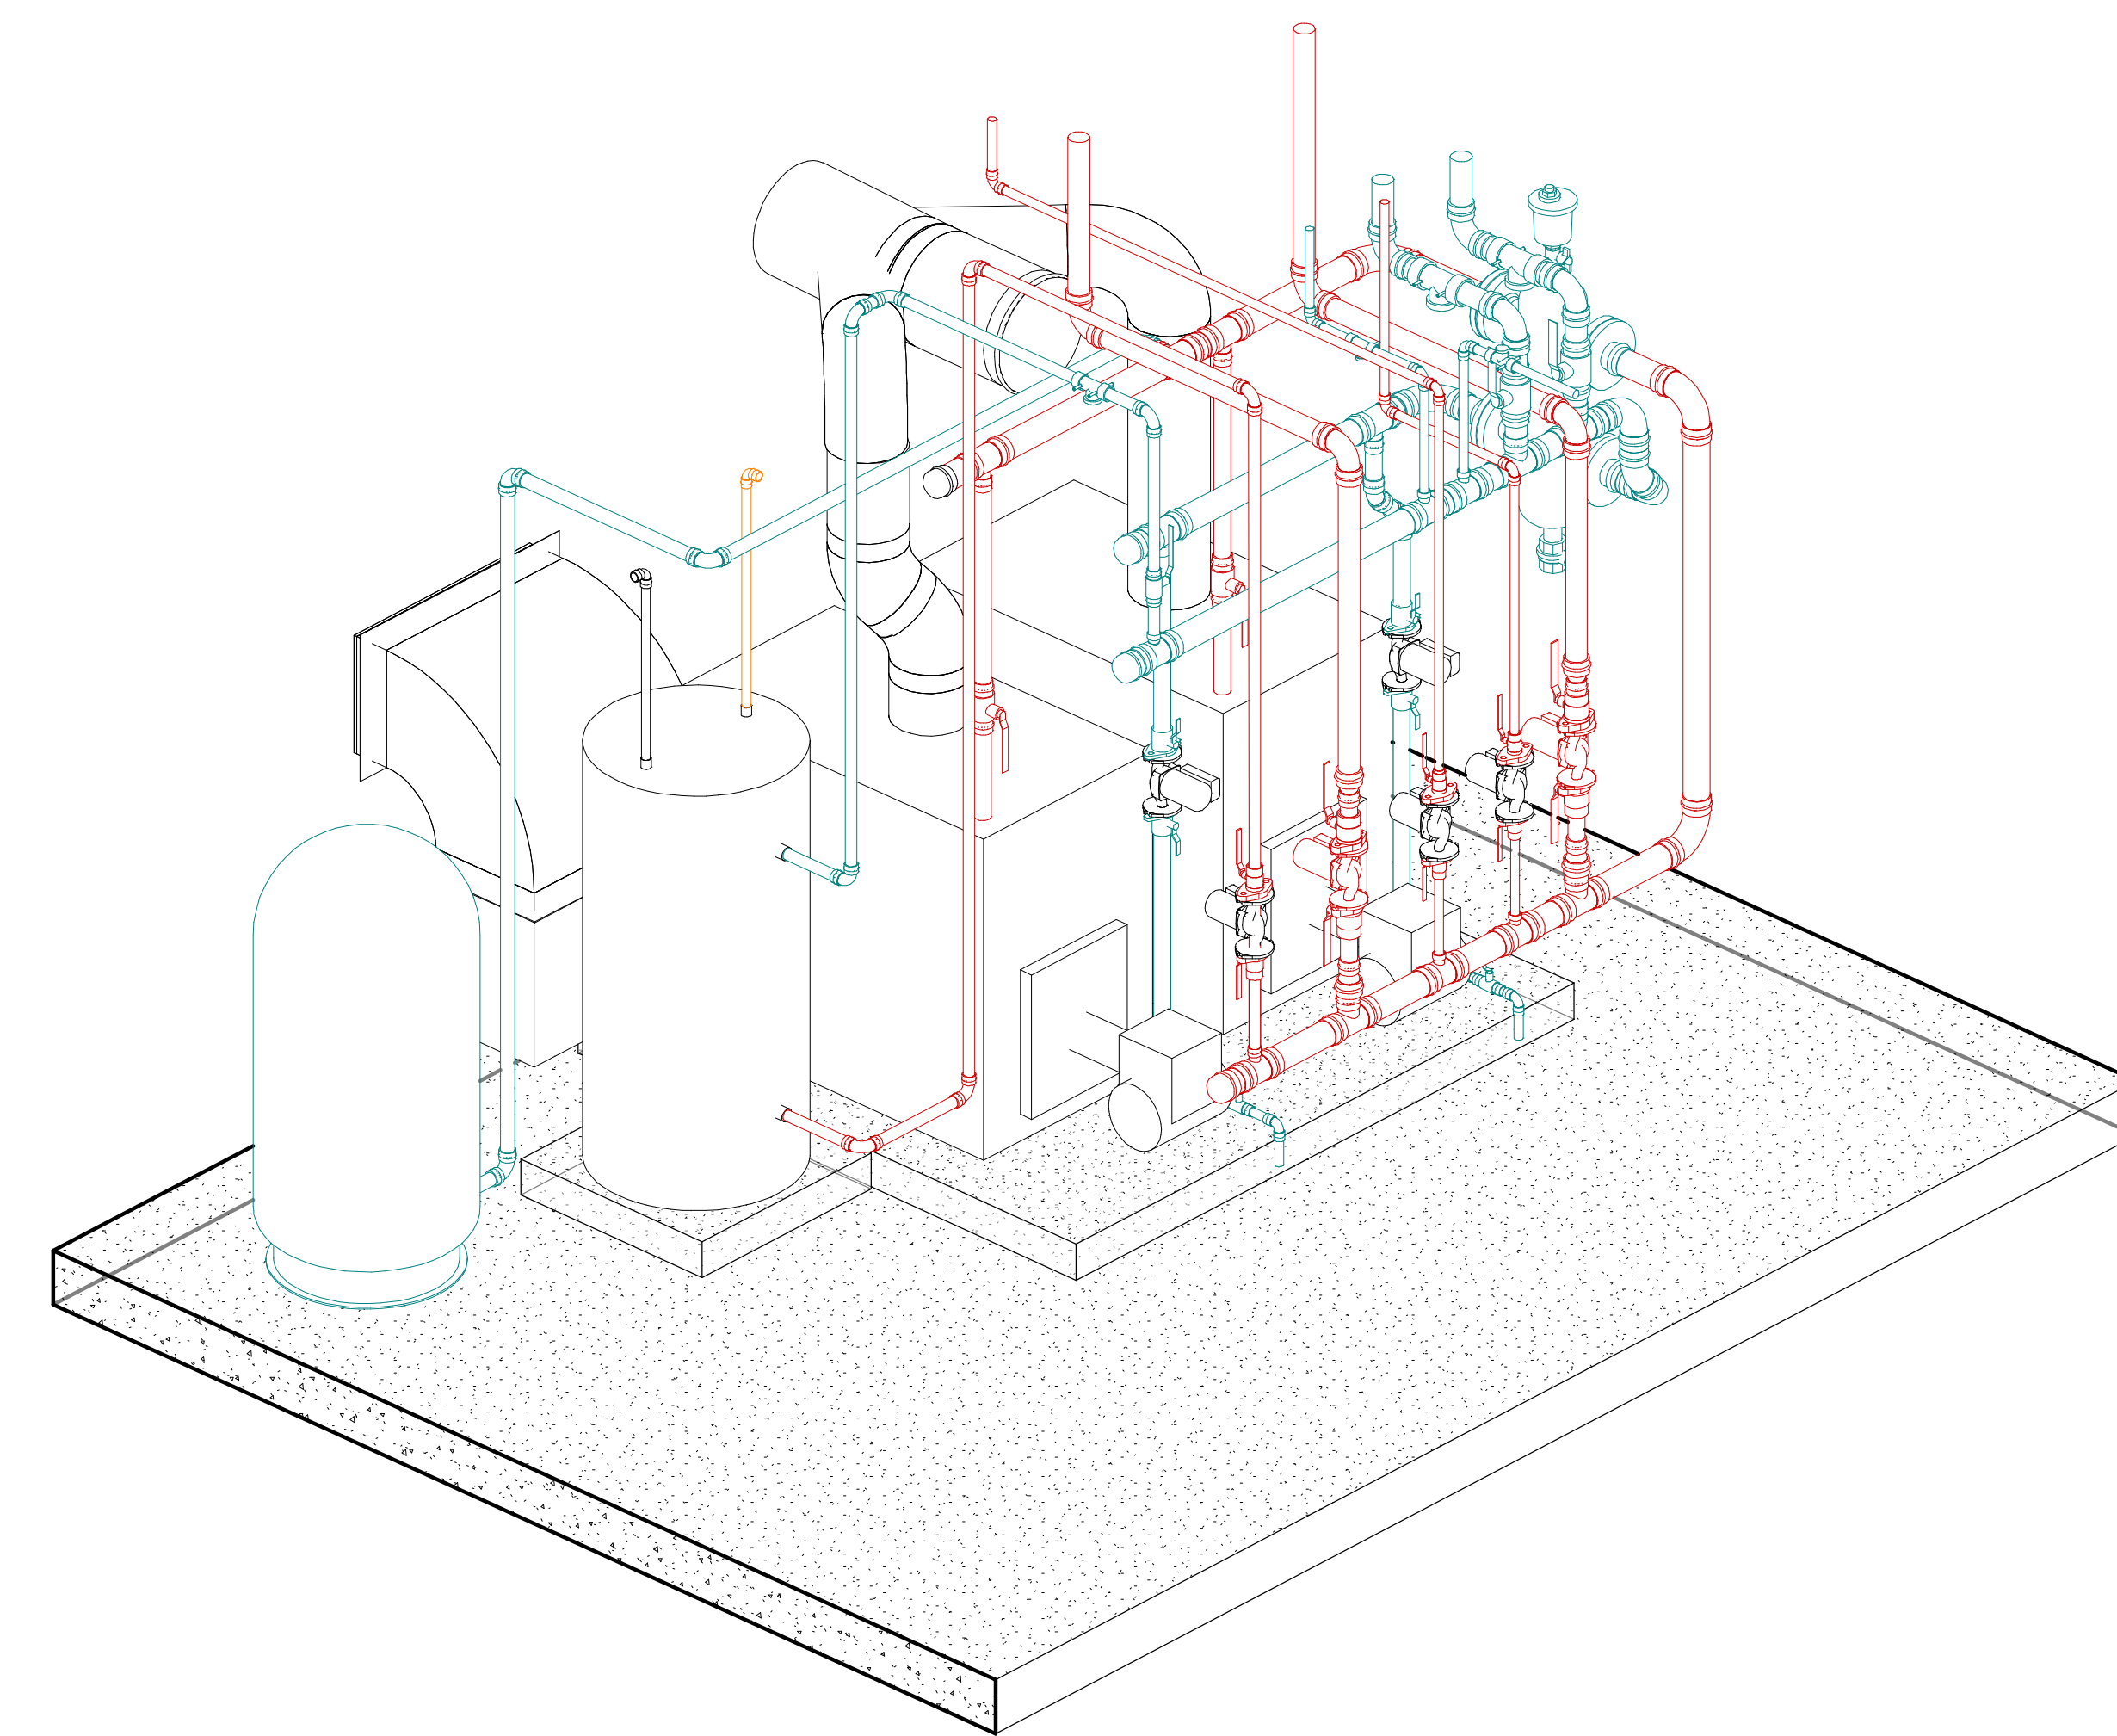

4 Carriage Barn 3D

No.	Description	Date
0	PRELIMINARY PLAN NOT FOR CONSTRUCTION	9/28/2020
1	ADDED CALEFFI / INDIRECT / EXPANSION TANK	10/9/2020
2	AS-BUILT	12/1/2020

Town of New Canaan

Boiler Replacements

667 South Ave  
 New Canaan, CT

CARRIAGE BARN PLAN

Project Number	5089
Date	12/1/2020
Drawn By	T.H.
Checked By	J.H.

M200.0

Scale 1" = 1'-0"