


COORDINATION SIGN OFF		
REP.	COMPANY	DATE

SHEET NOTES:

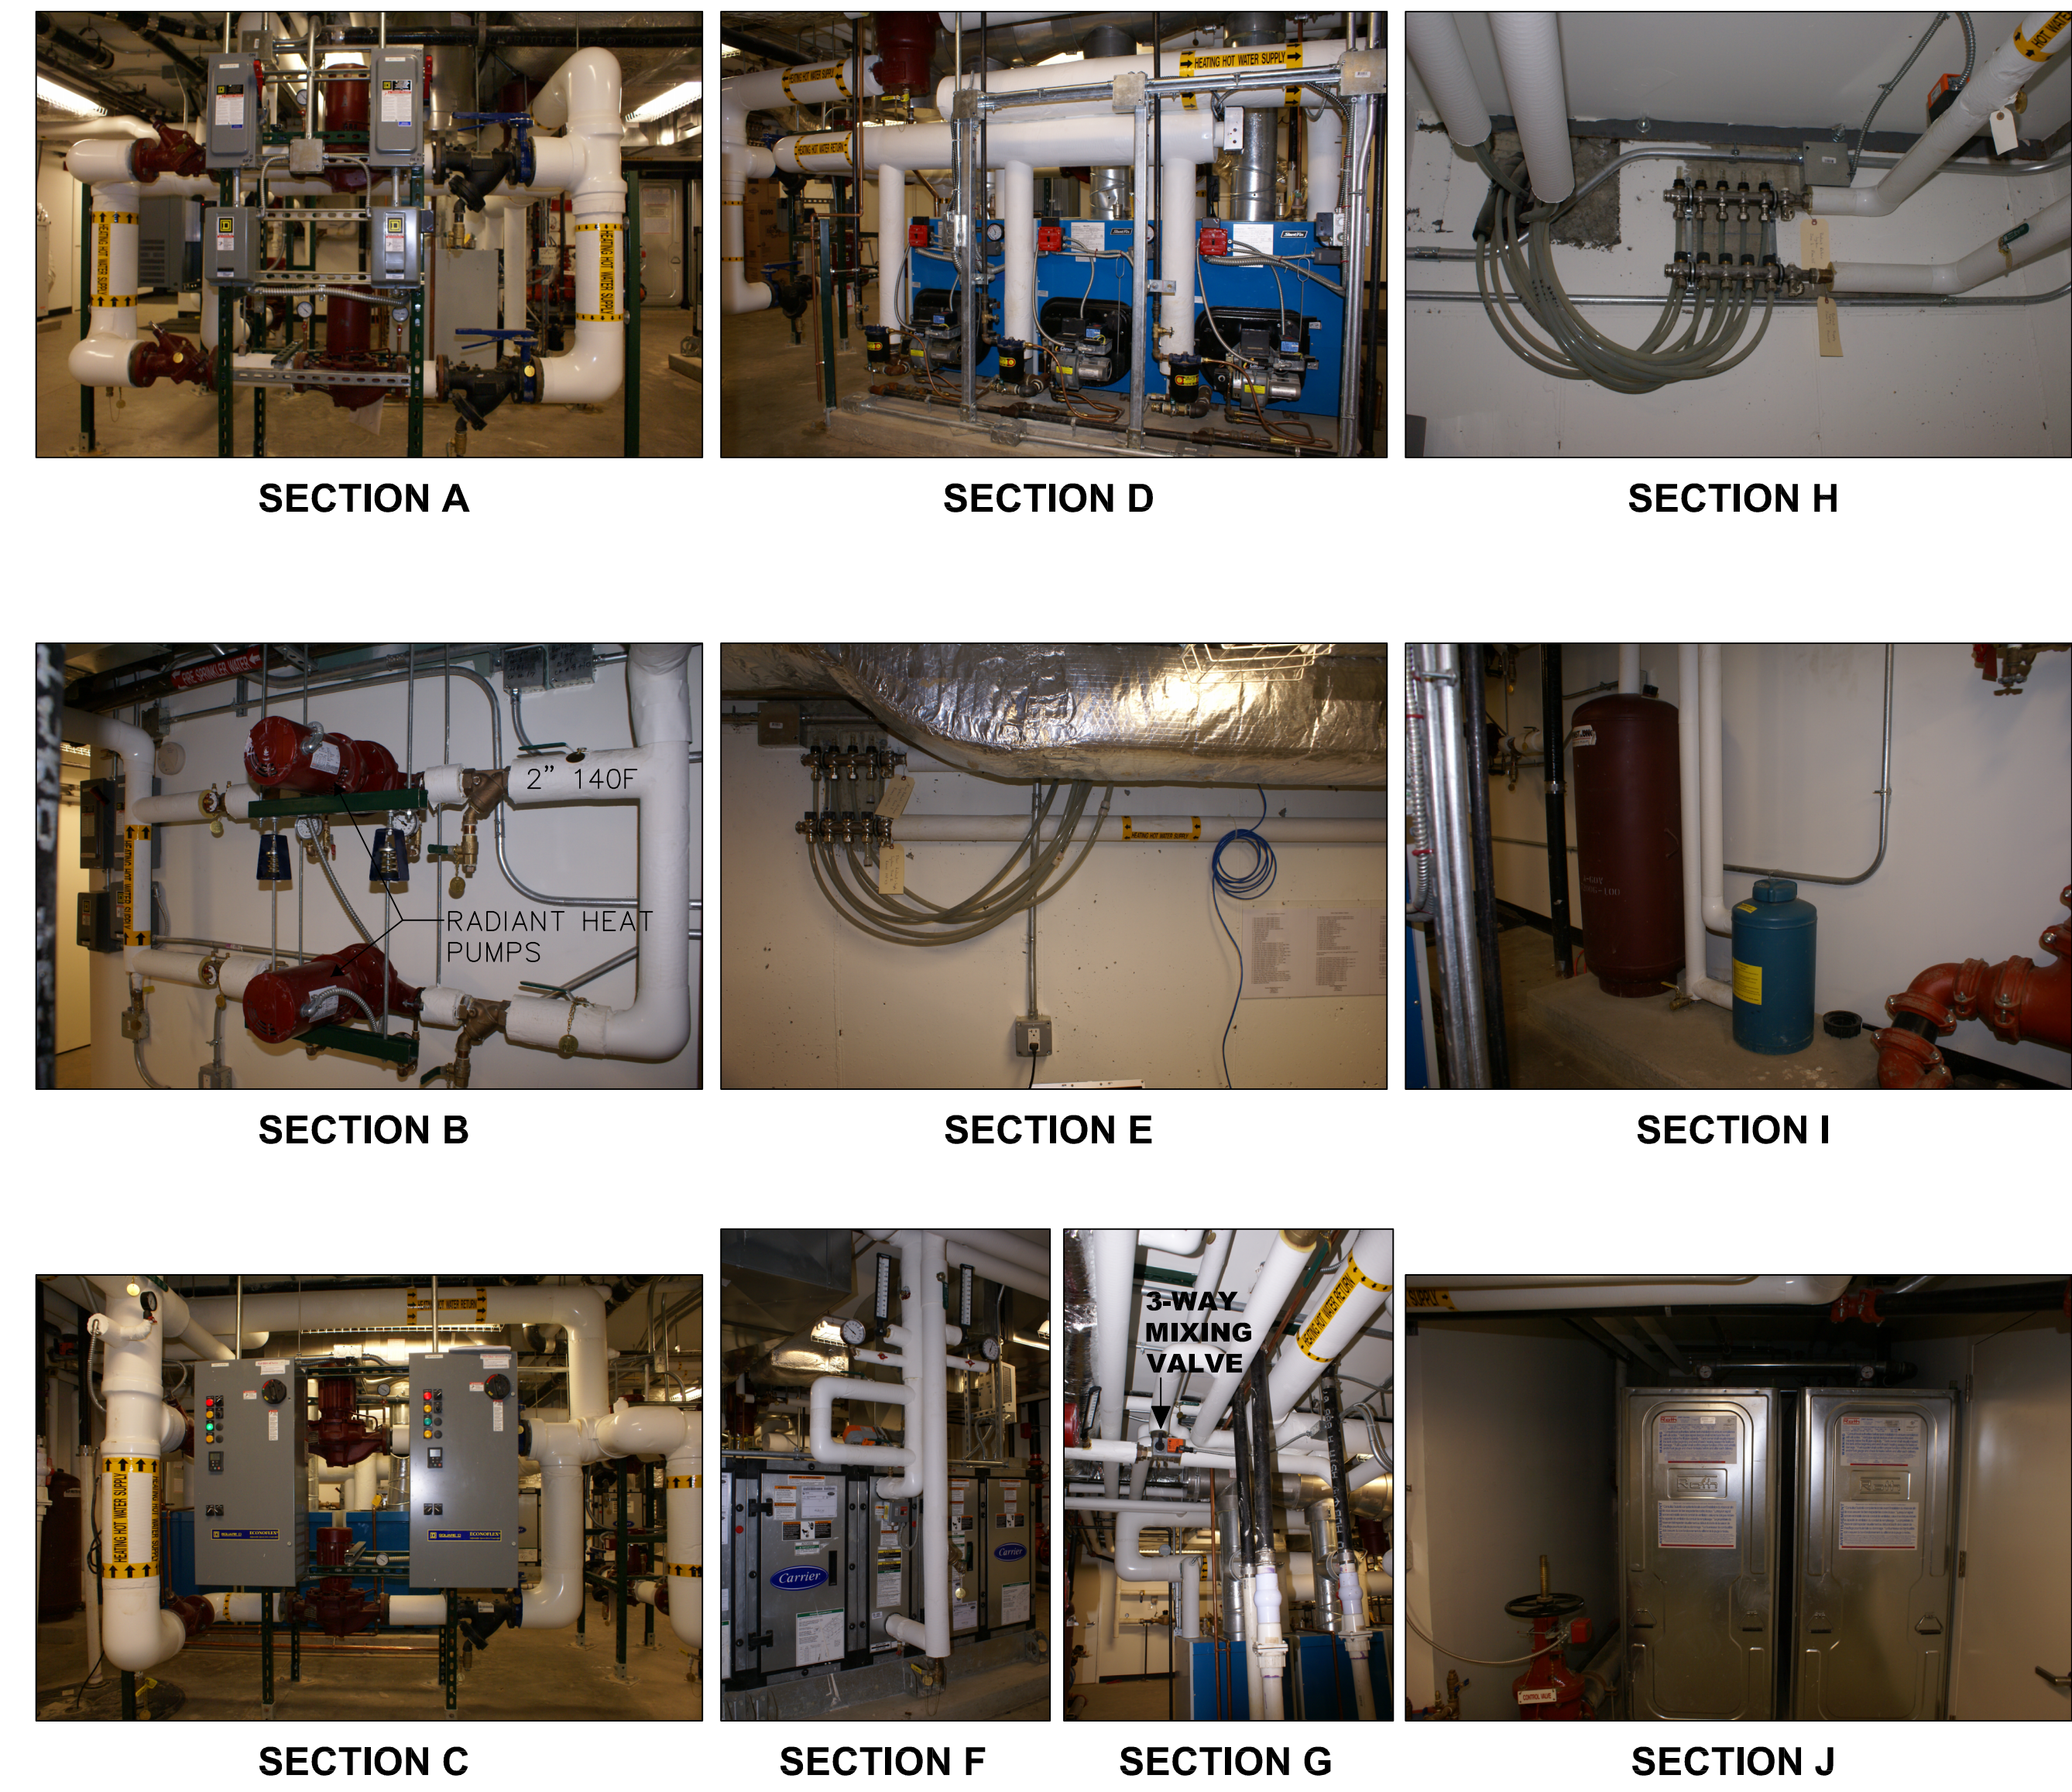

NO.	REVISION	DATE
DWG. TITLE BOILER ROOM AS-BUILT PLAN		
PROJECT THE CHILDREN'S SCHOOL 12 GARY ROAD STAMFORD, CONNECTICUT		

**EMS**  
 EASTERN MECHANICAL SERVICES, INC  
 64 TRIANGLE STREET SUITE H2  
 PO BOX 246  
 DANBURY, CT 06810







DES. BY	DWN. BY	DATE	DWG. NO.
EMS	TAH	12/22/07	M-1
EMS JOB NO.	CHECKED BY	SCALE	
1245	TAH	3/16" = 1'-0"	





REP.	COMPANY	DATE

**SHEET NOTES:**  
 1. Start all tubing 6" off Wall.  
 2. Tubing Spacing 9" on centers.

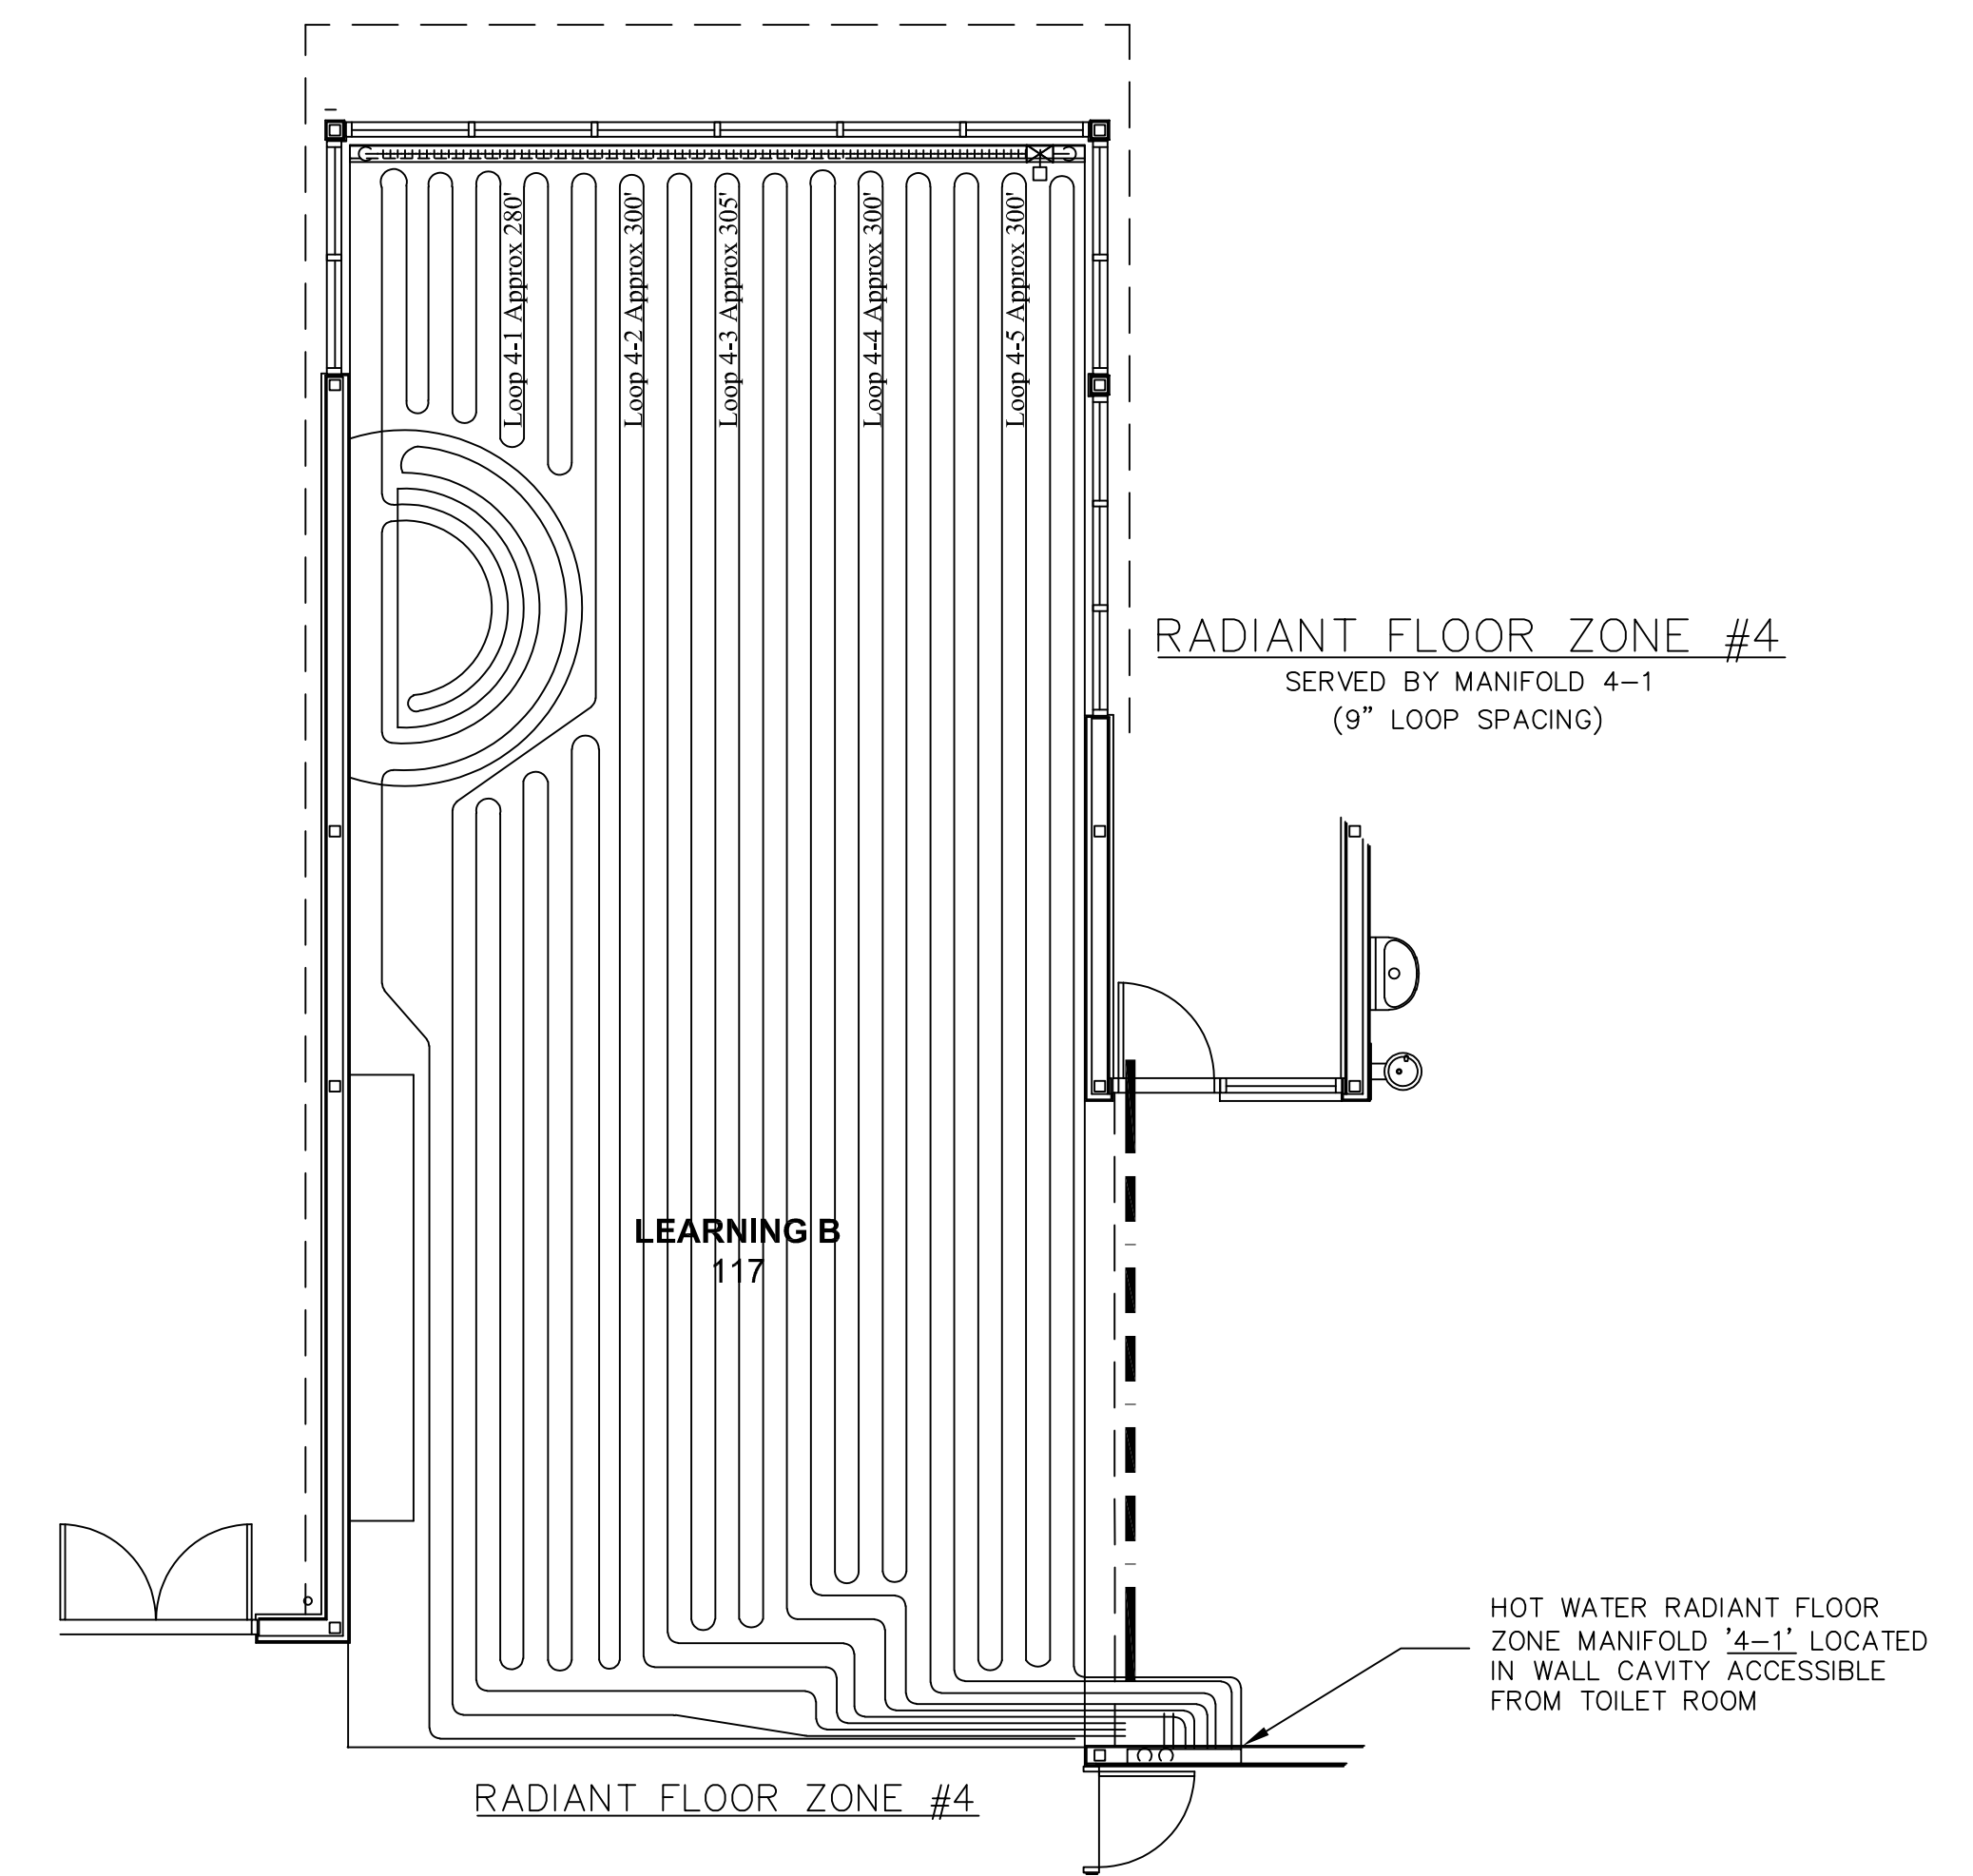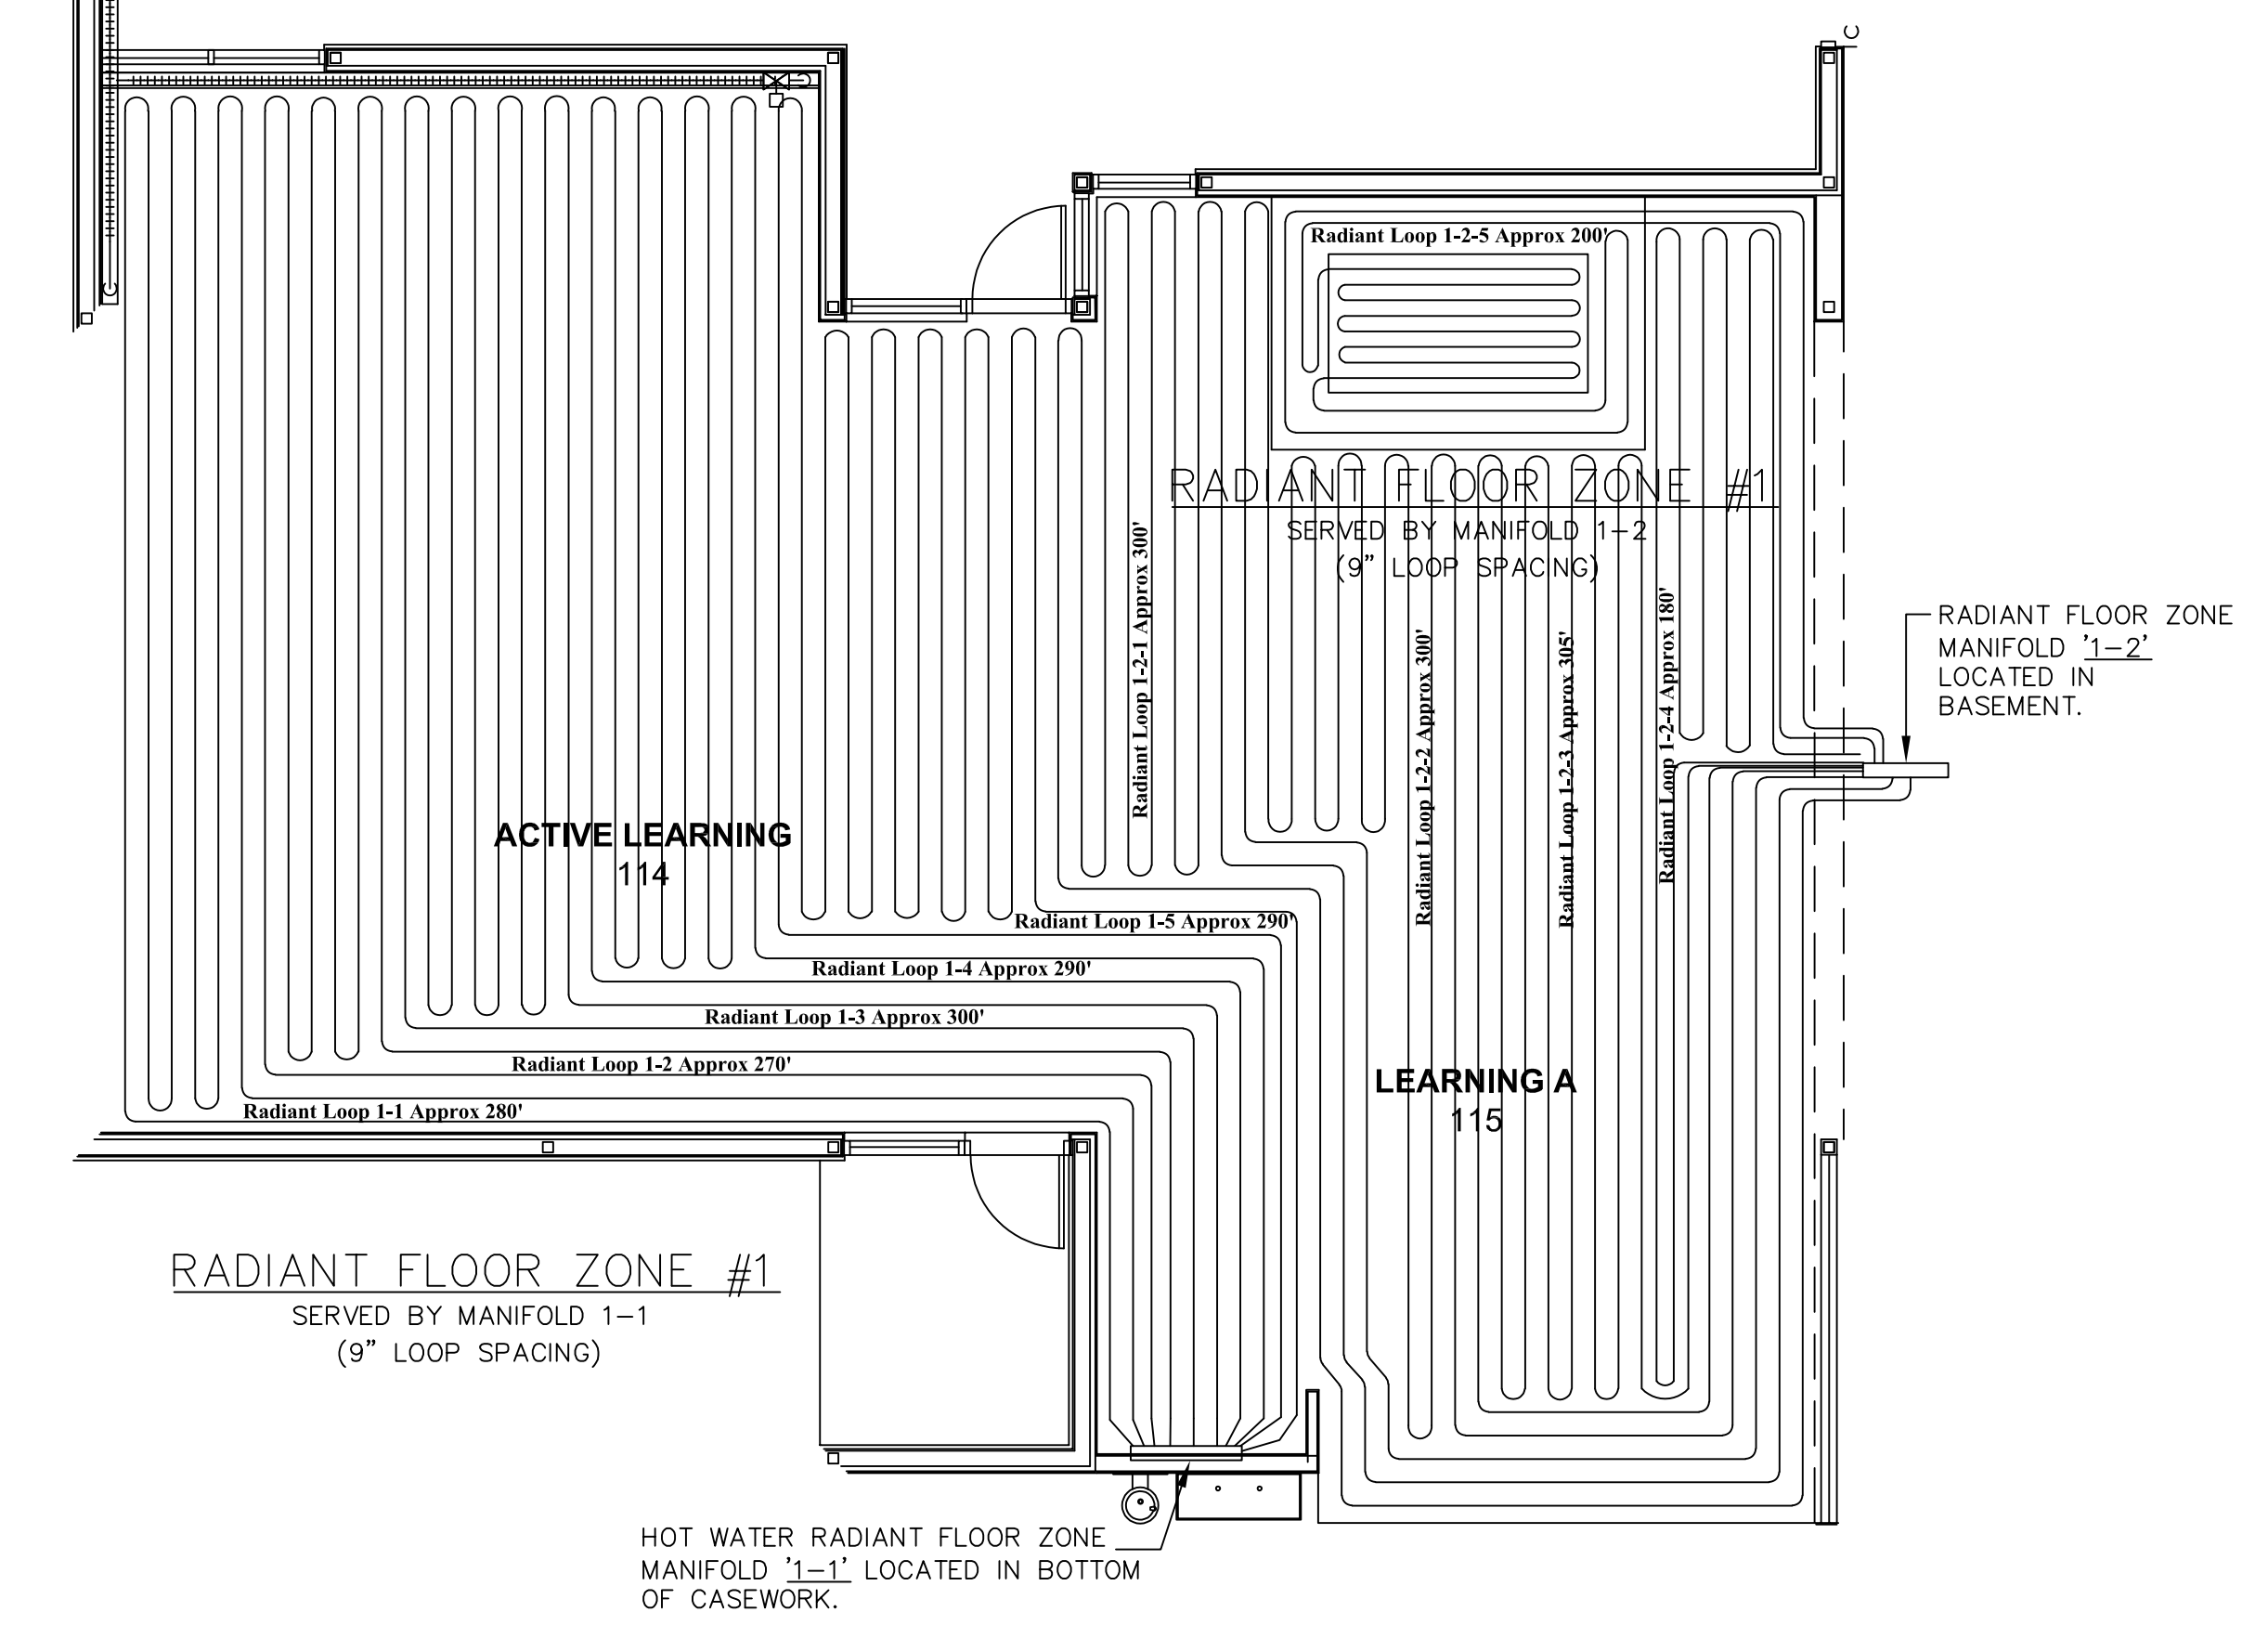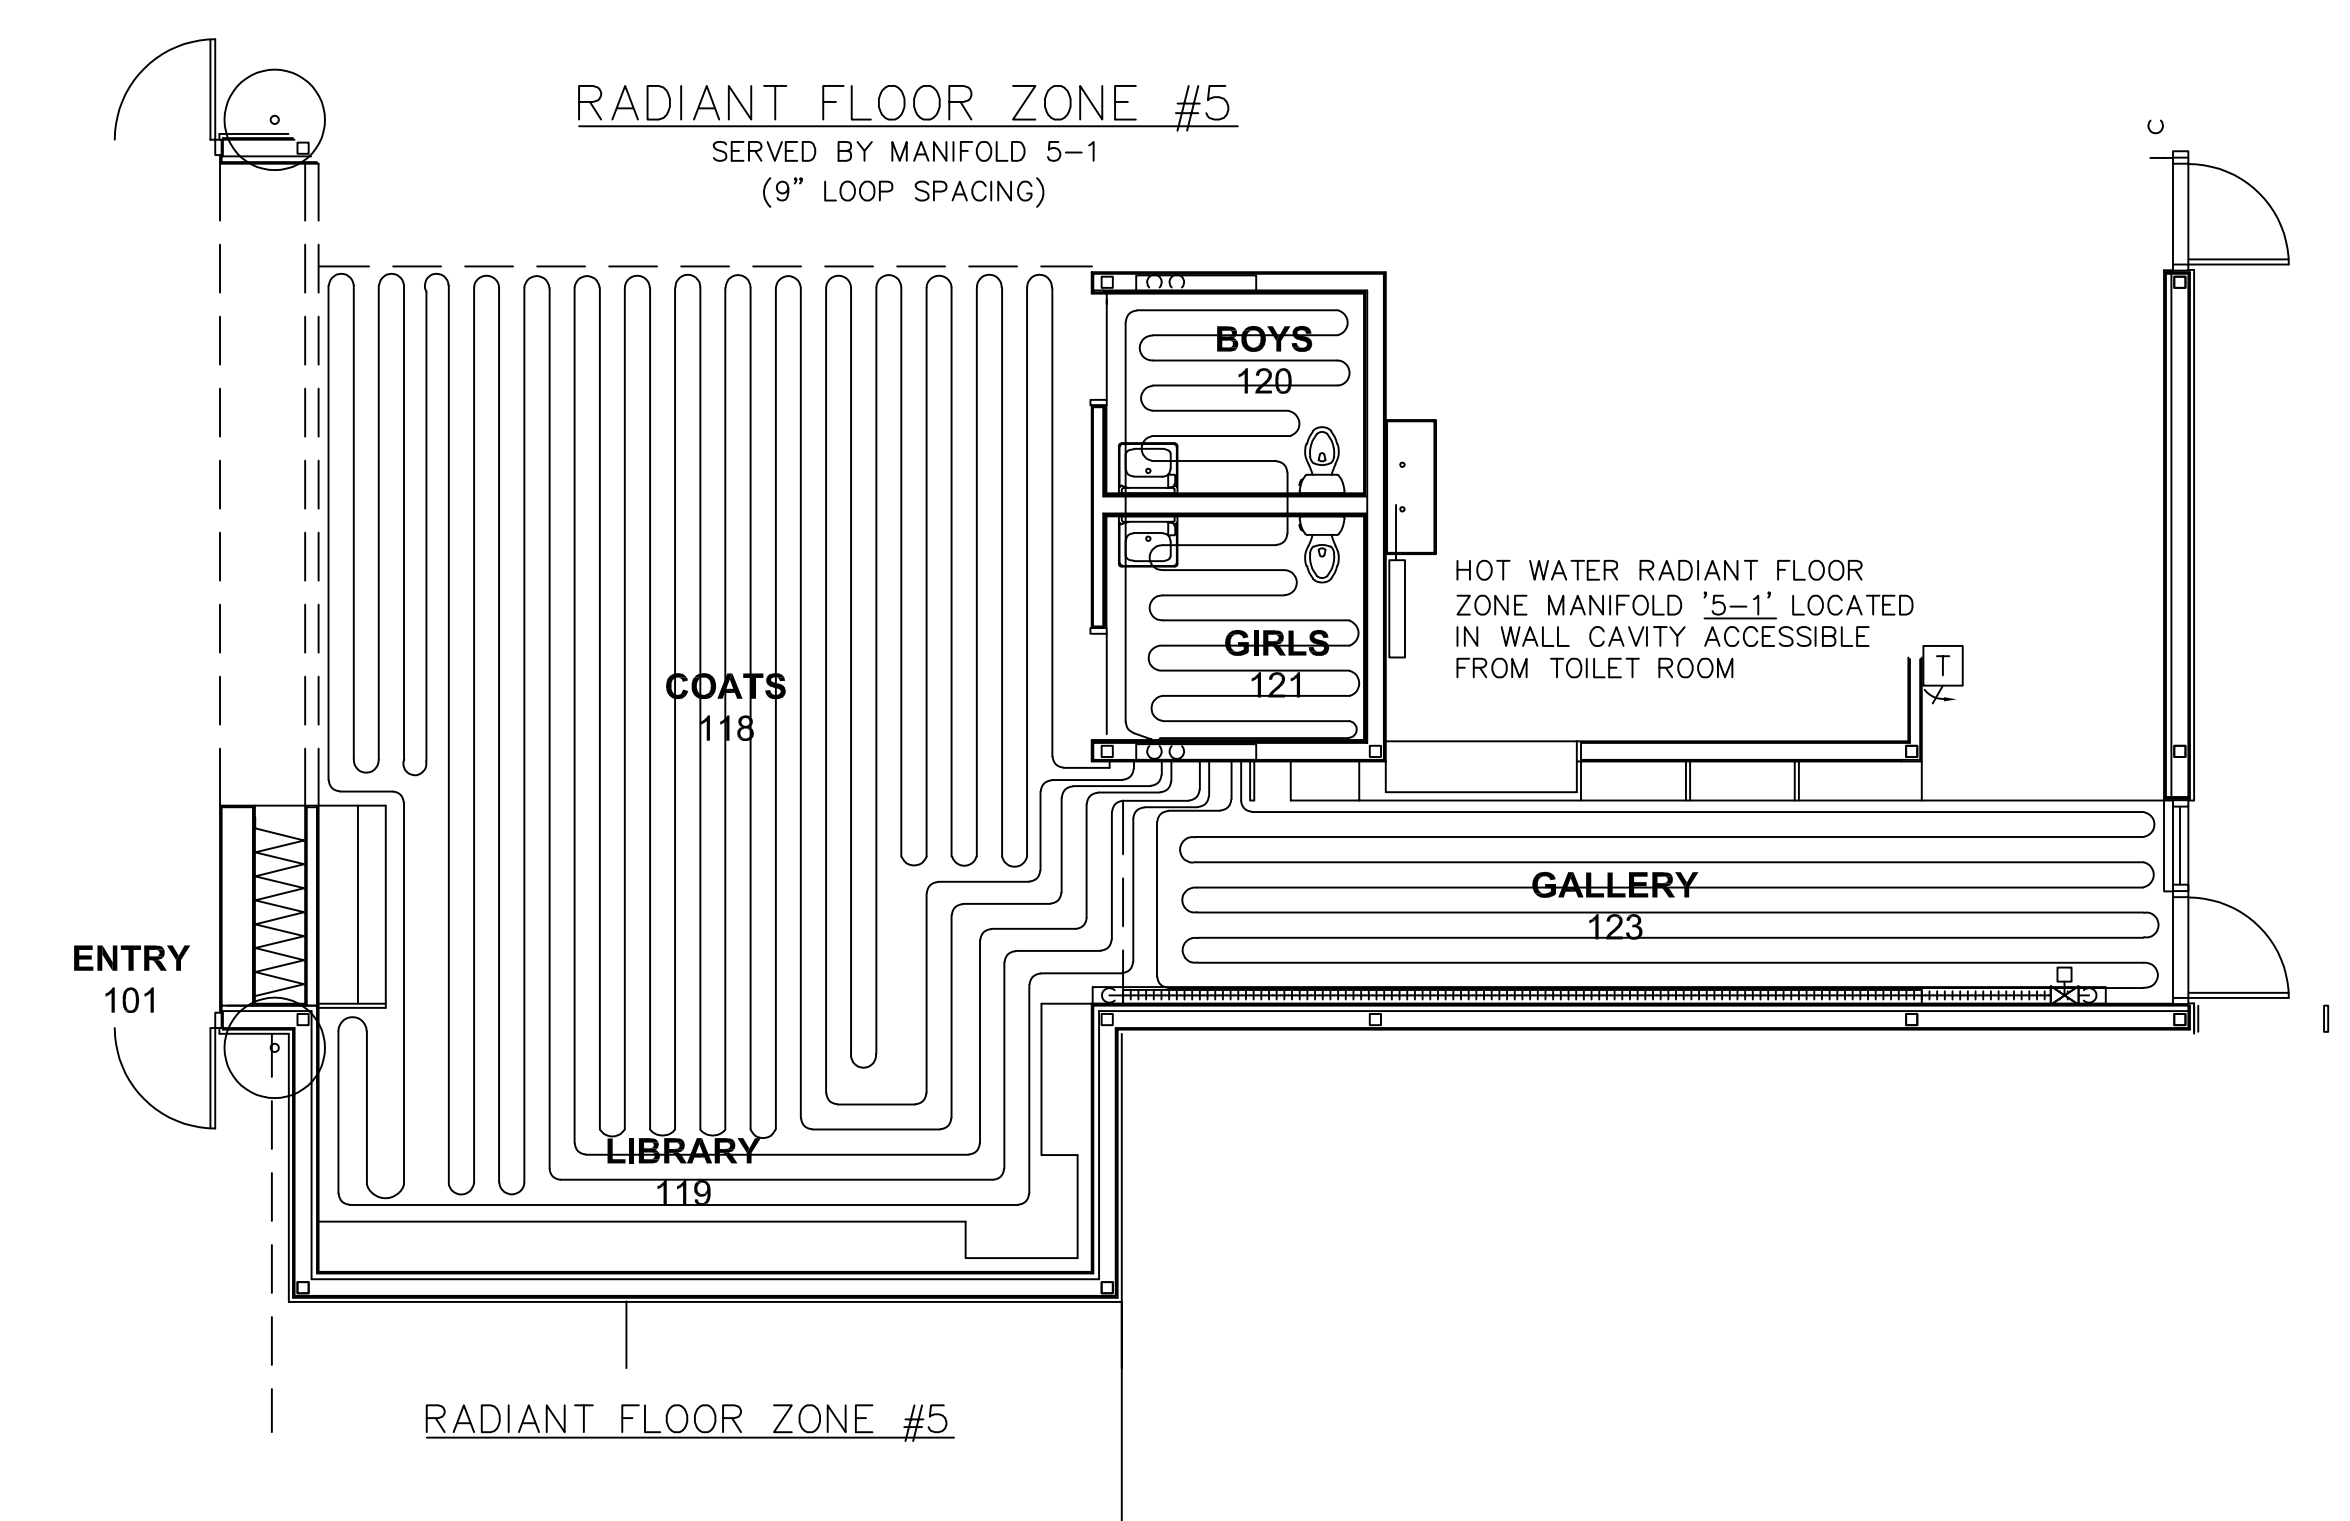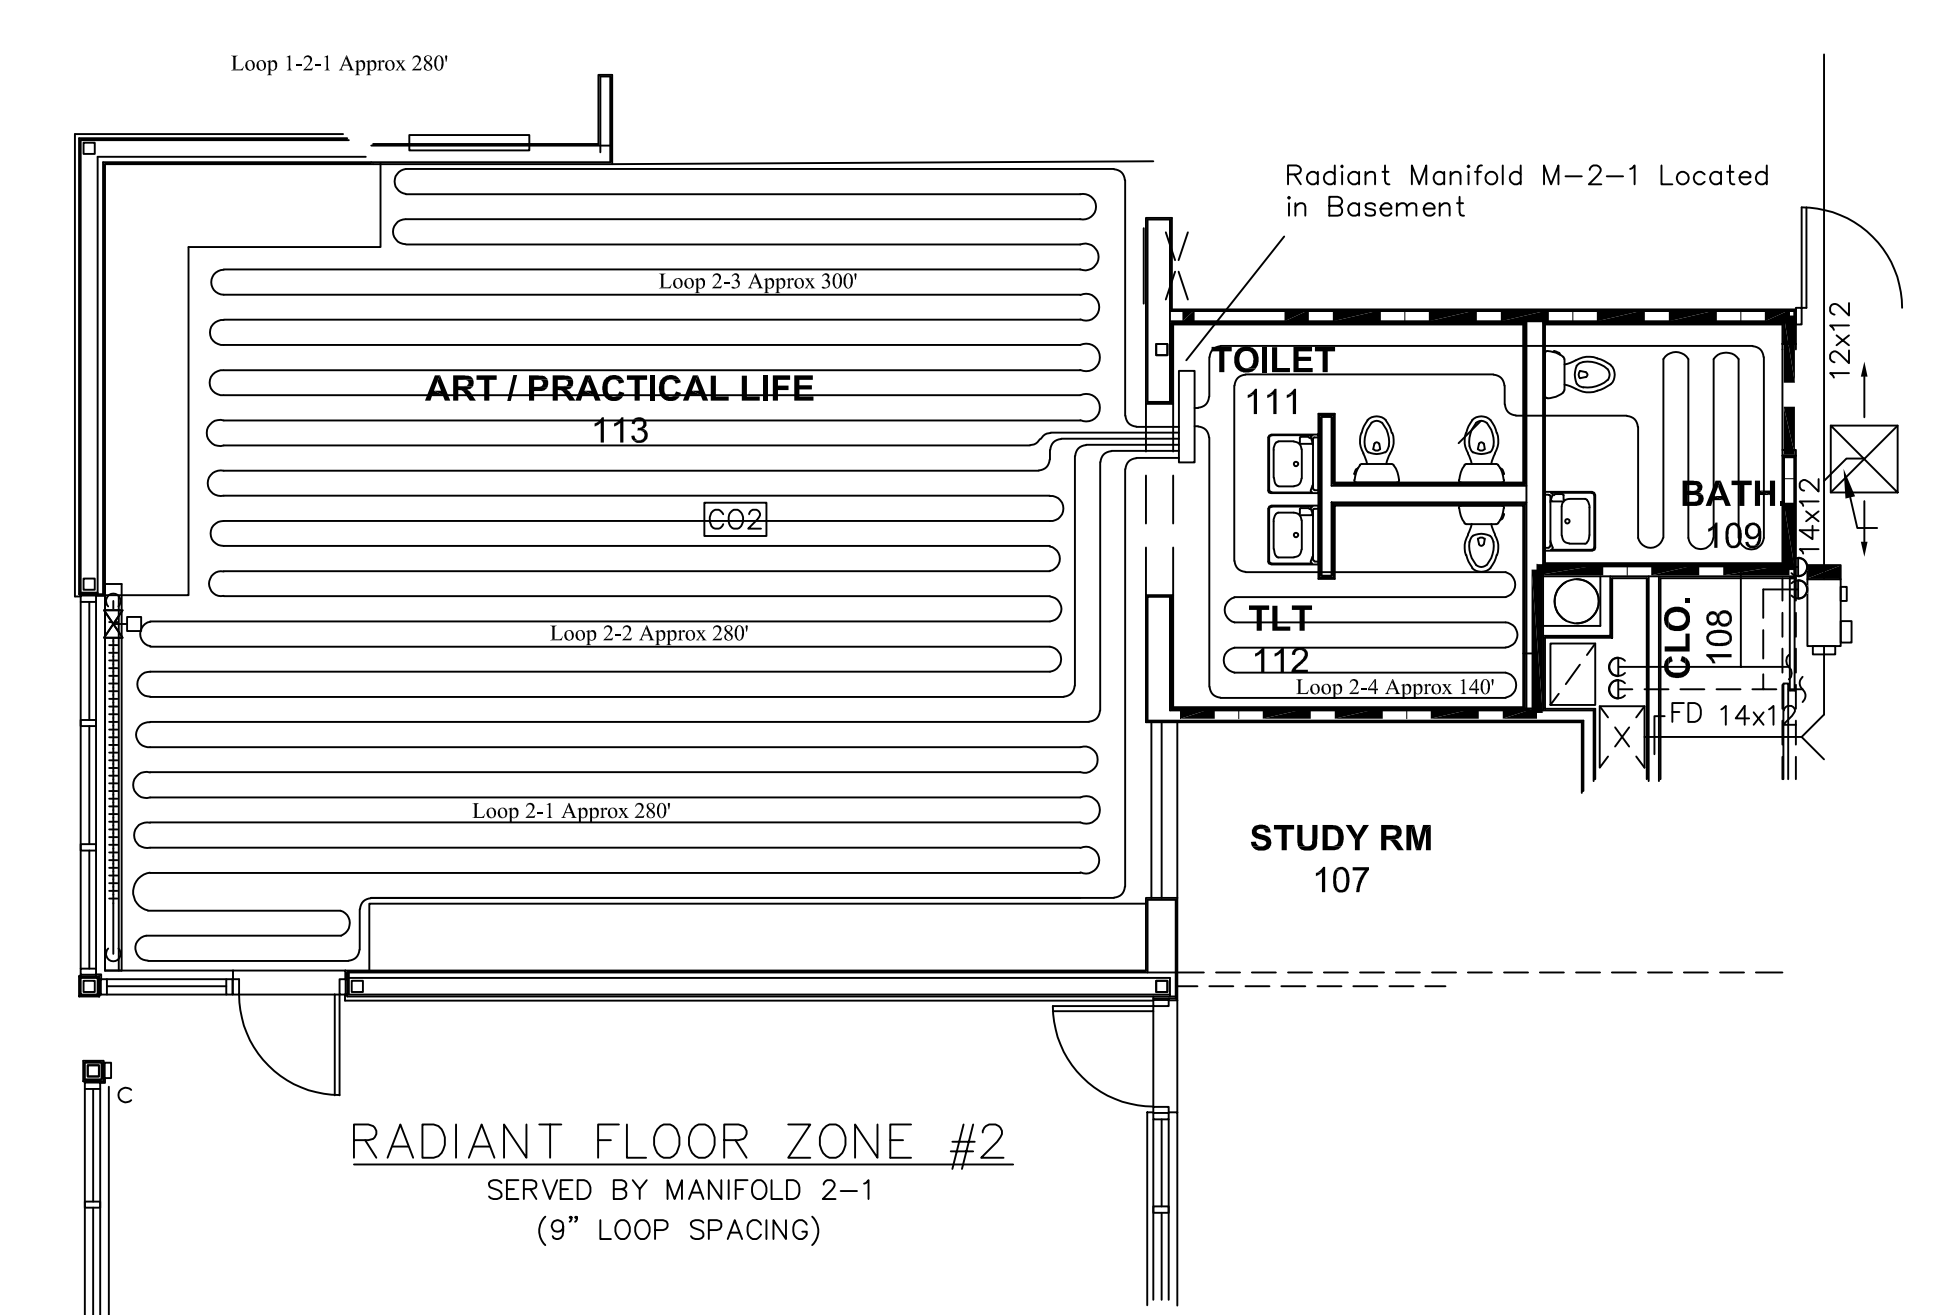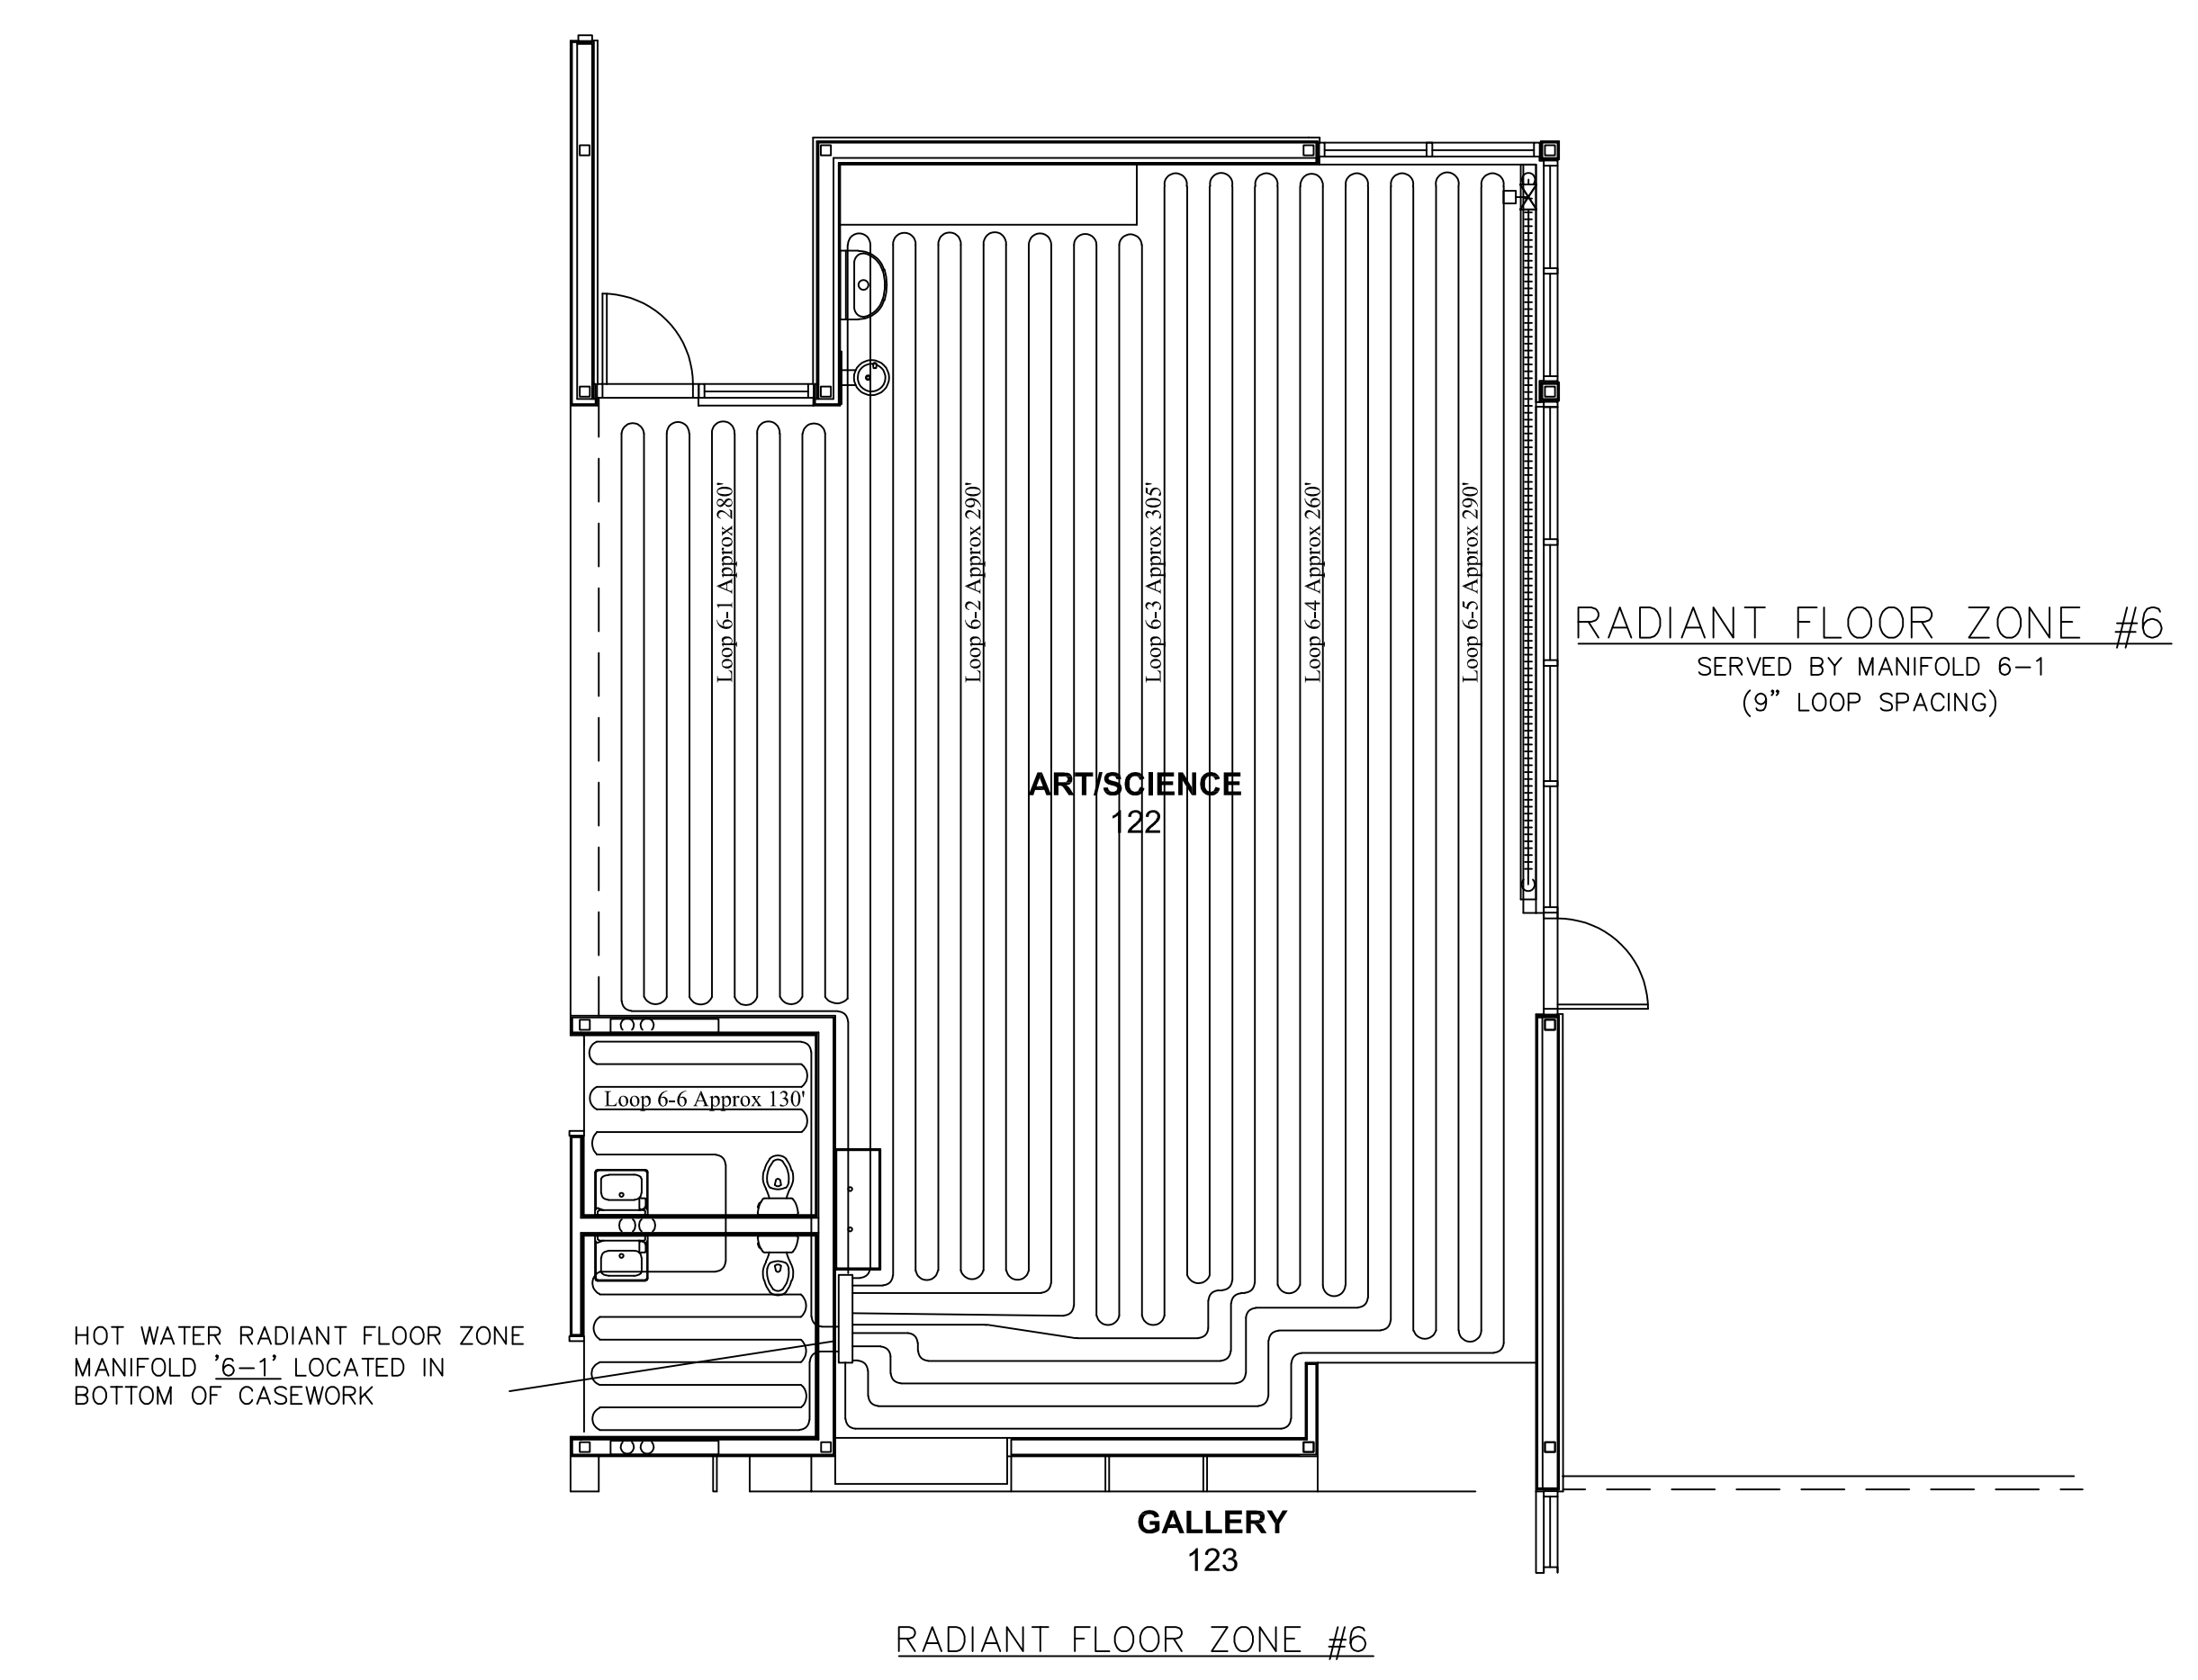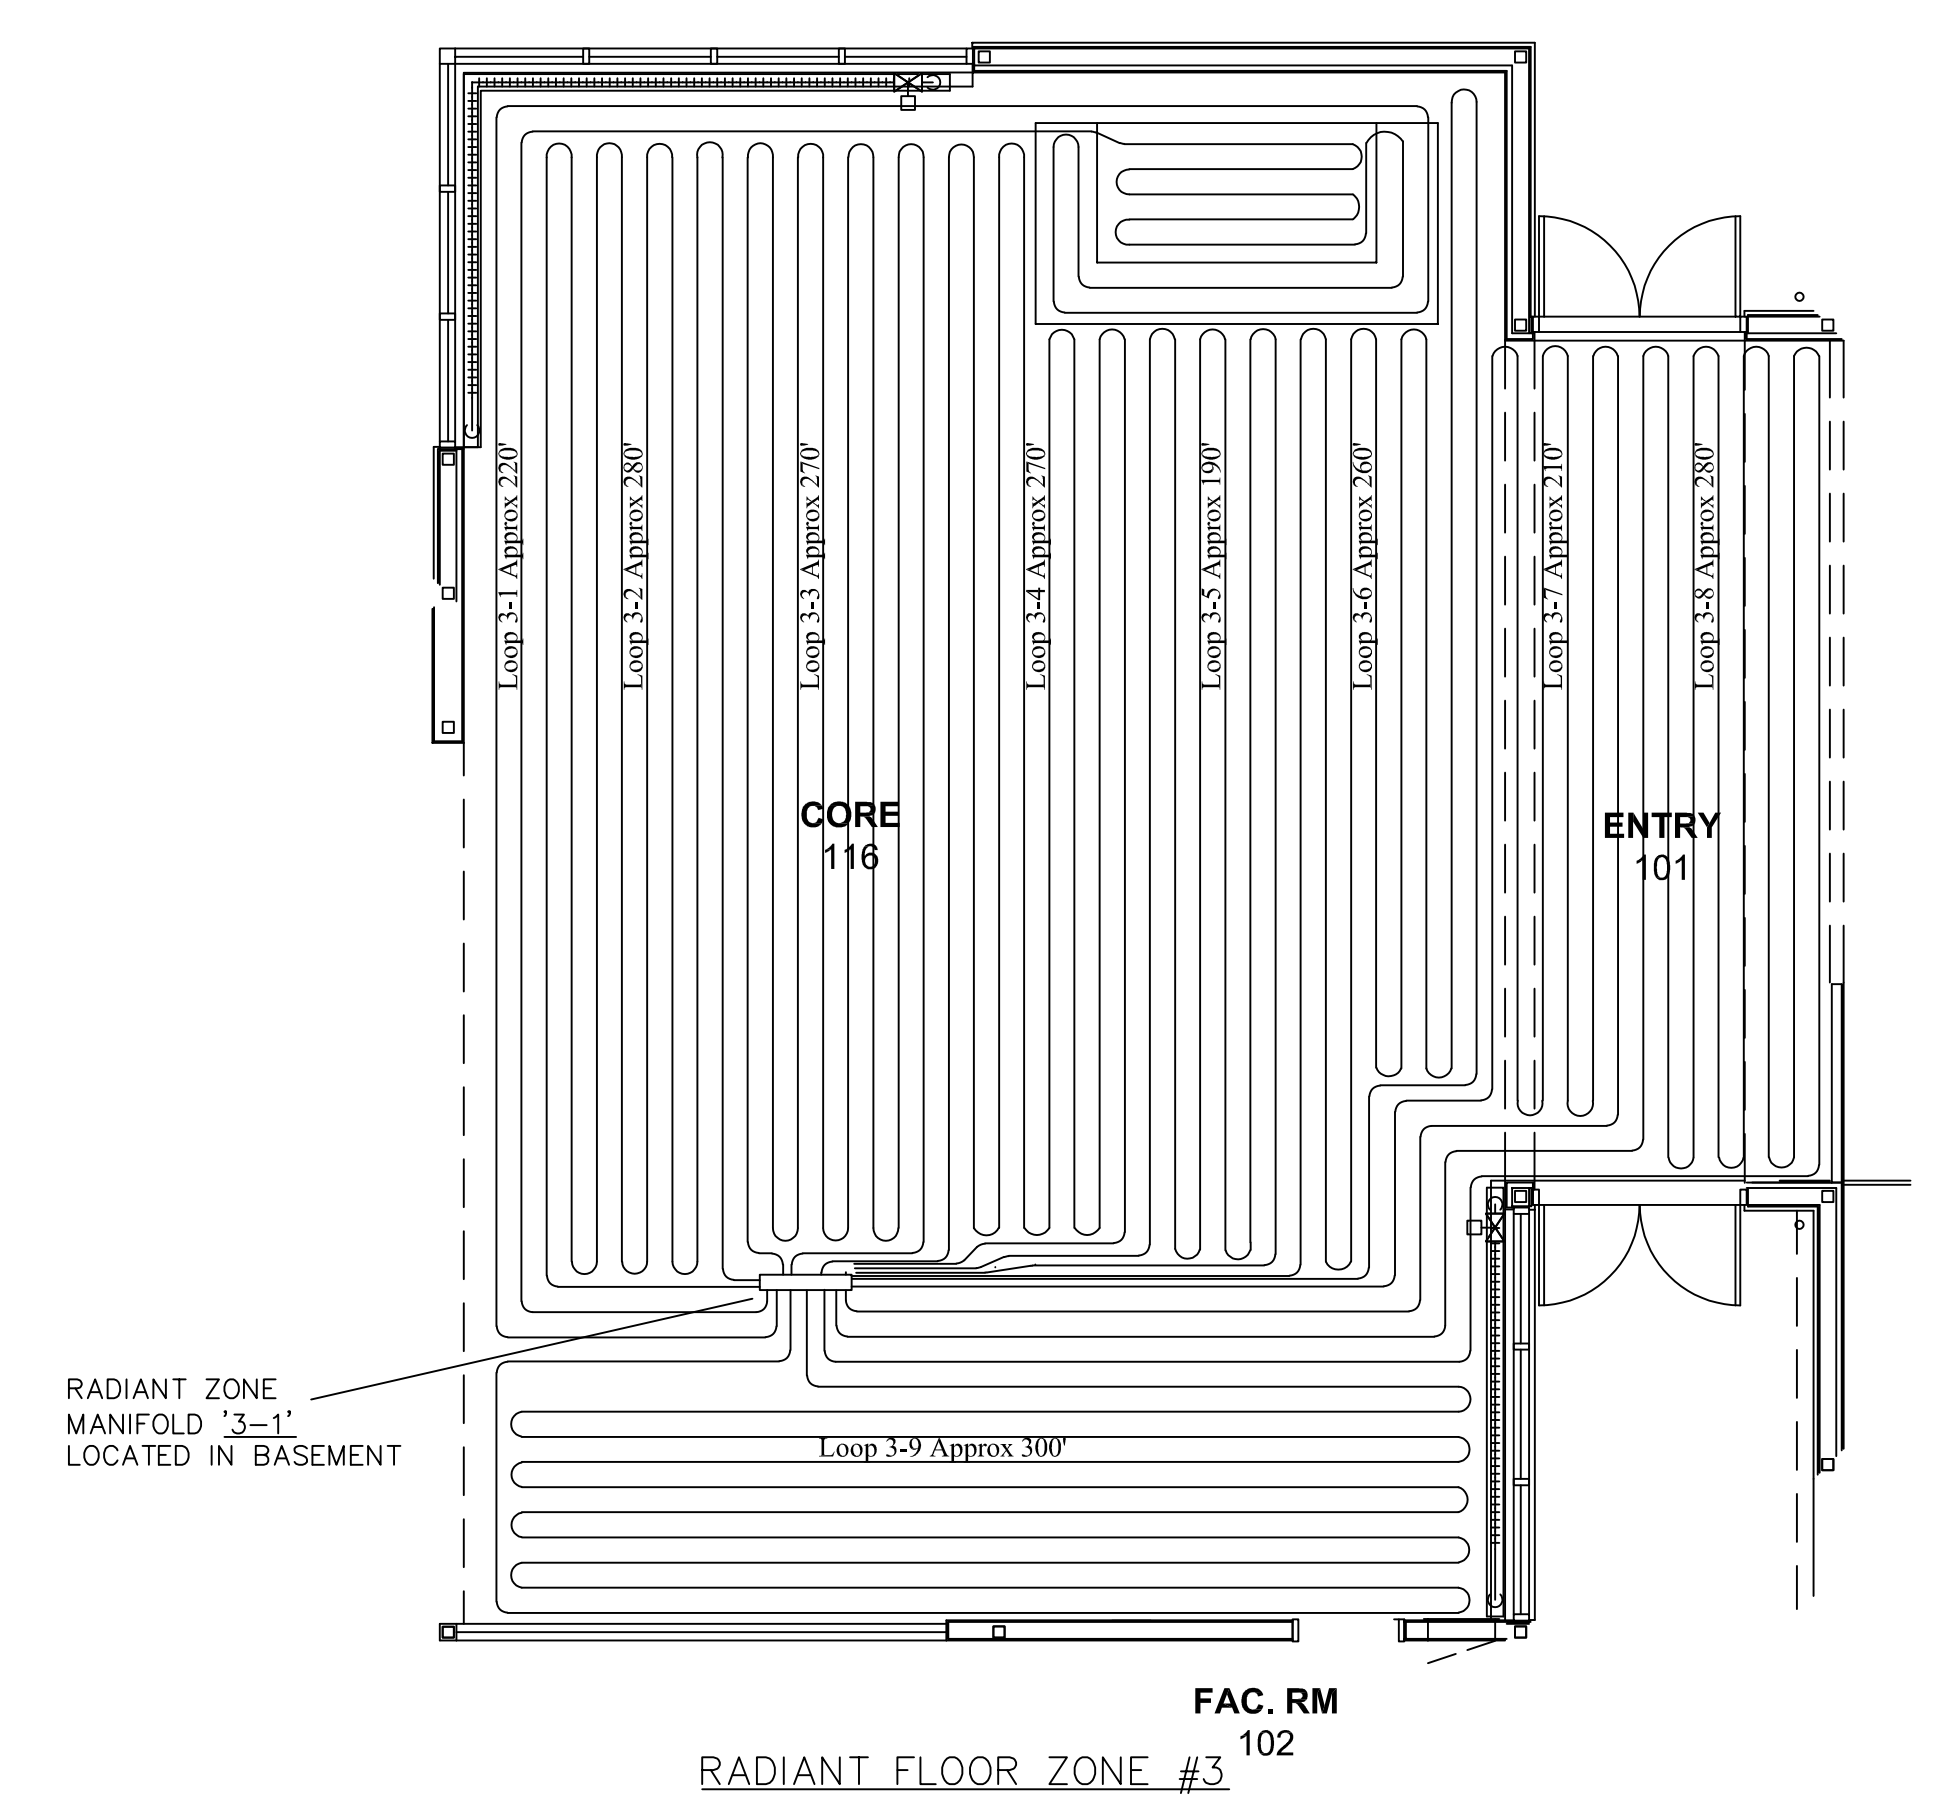

**M MECHANICAL MARKETING**  
 105 Woodmont Road  
 Milford CT 06460  
 Phone (203)877-5800  
 FAX (203)783-9042

NO.	REVISION	DATE

DWG. TITLE  
**RADIANT TUBING LAYOUT AS-BUILT**

PROJECT  
**THE CHILDREN'S SCHOOL  
 12 GARY ROAD  
 STAMFORD, CONNECTICUT**

**EMS**  
 EASTERN MECHANICAL SERVICES, INC  
 64 TRIANGLE STREET SUITE H2  
 PO BOX 246  
 DANBURY, CT 06810

DES. BY	DWN. BY	DATE	DWG. NO.
MM	MGS	12/22/07	M-3
EMS JOB NO.	CHECKED BY	SCALE	
1245	MGS	NTS	